

# OTTAWA COUNTY ENGINEERS OFFICE

REFERENCE NO. 3-6-15-C  
 NE CORNER POST SEC. 3  
 SALEM TWP.  
 SHEET 1 OF 1.

ROUTE: T-101 LEUTZ RD.

TOWNSHIP: SALEM


SECTION: 3

T 6 NR 15 E.

NORTHING:

EASTING:

DATUM:

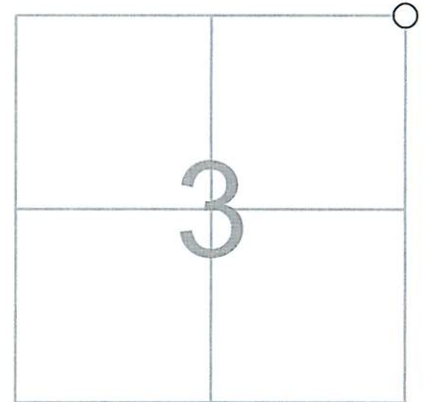

PERSONNEL:  
 M. WITTMAN, P.S.  
 J. ALLEN

DATE / WEATHER / TEMP:  
 JUNE 13, 2016  
 SUNNY - E  
 68° F

### MONUMENT INFORMATION

MONUMENT TYPE: FD. 5/8" Ø IRON PIN  
 ON SURFACE - BELOW: 0.65'  
LEFT - CL PAV'T - RIGHT: 15.30'



### MISC. INFORMATION

THIS POINT IS OFF WEST SIDE OF PAVEMENT IN SHOULDER AND IS COVERED BY A 4" Ø TIN CAN.

JUNE 13, 2016

FD 5/8" Ø IRON PIN

