

OTTAWA COUNTY ENGINEERS OFFICE

REFERENCE NO. 3-6-15-D
WEST QUARTER POST SEC. 3
SALEM TWP.
SHEET 1 OF 1.

ROUTE: T-102 BEHLMAN RD.
NORTH OF SR #163

TOWNSHIP: SALEM

SECTION: 3

T 6 NR 15 E.


NORTHING:

EASTING:

DATUM:

PERSONNEL:
M. WITTMAN, P.S.
J. ALLEN

DATE / WEATHER / TEMP:
JUNE 13, 2016
SUNNY - E
71° F

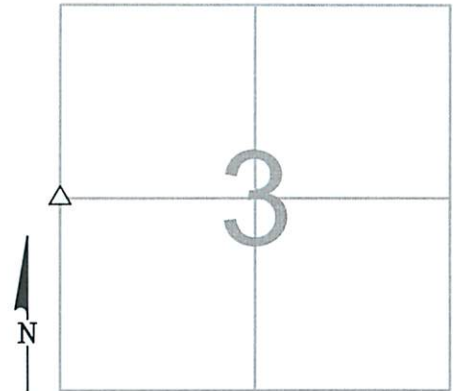

MONUMENT INFORMATION

MONUMENT TYPE: FD. POINTED LIMESTONE
ON SURFACE - BELOW: 1.35'
LEFT - CL PAV'T - RIGHT: 3.60'

4" x 4-1/2" POINTED LIMESTONE.

USED CENTER OF HIGH POINT OF STONE.



MISC. INFORMATION

IRON PIN OVER STONE PER D.J.N 10-7-1968. FD 1/2" x 4" LONG SQUARE TOP BOLT 0.45' BELOW SURFACE, TIED W/ X-TIES AND DUG FOR STONE AS BOLT WAS LOOSE. FD 5/8" Ø IRON PIN 0.70' BELOW SURFACE DIRECTLY UNDER BOLT, WAS ALSO LOOSE, REMOVED AND CONTINUED TO STONE. SQUARE TOP BOLT WAS 0.08' WEST AND 0.02' NORTH OF HIGH POINT USED ON STONE.

JUNE 13, 2016

SET 1" SQUARE IRON PIN
IN MONUMENT BOX OVER
STONE

