

# OTTAWA COUNTY ENGINEERS OFFICE

REFERENCE NO. 3-6-15-E  
CENTER POST SECTION 3  
SALEM TWP.  
SHEET 1 OF 1.

**PERSONNEL:**

M. WITTMAN, P.S.  
J. ALLEN  
J. HAYES - BEC ASSOC.  
S. MARTIN - BEC ASSOC.

**DATE / WEATHER / TEMP:**

AUGUST 24, 2017  
OVERCAST - NE  
73° F

ROUTE: PRIVATE DRIVEWAY

TOWNSHIP: SALEM


SECTION: 3

T 6 NR 15 E.

NORTHING: 671624.0941

EASTING: 1799758.5587

DATUM: ODOT VRS (NAD83) 2011

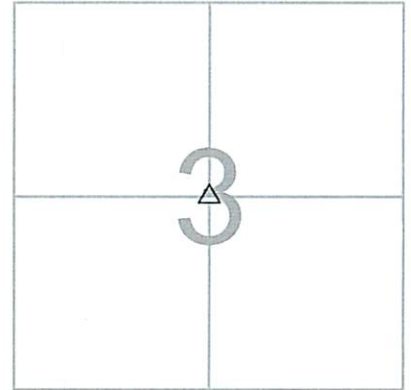

MONUMENT INFORMATION

MONUMENT TYPE: FD. 4" X 7" HARDHEAD STONE  
ON SURFACE - BELOW: 1.08'  
LEFT - CL PAV'T - RIGHT: ON C/L STONE DRIVE

STONE IRREGULAR SHAPED.

SET DRILL HOLE IN CENTER OF STONE.



MISC. INFORMATION

PLACED MONUMENT BOX OVER STONE.  
MONUMENT BOX IS 0.40' BELOW THE STONE  
DRIVE SURFACE. COORDINATES LISTED WERE  
PROVIDED BY BEC ASSOCIATES, INC. ON  
8-24-2017.

AUGUST 24, 2017

SET MONUMENT BOX  
OVER STONE

