

OTTAWA COUNTY ENGINEERS OFFICE

REFERENCE NO. 31-7-15-B
NORTH QUARTER POST SEC. 31
SALEM TWP.
SHEET 1 OF 1.

ROUTE: C-98 SALEM-CARROLL RD. @
T - 100 VOGEL RD.

TOWNSHIP: SALEM

SECTION: 31

T 7 NR 15 E.

NORTHING:

EASTING:

DATUM:

PERSONNEL:

M. WITTMAN, P.S.
J. ALLEN
C. MILLER

DATE / WEATHER / TEMP:

AUGUST 6, 2009
SUNNY N
68° F



MONUMENT INFORMATION


MONUMENT TYPE: FLAT HARDHEAD STONE W/ DH
ON SURFACE - BELOW: 1.53'
LEFT - CL PAV'T - RIGHT: 2.30'
IRREGULAR SHAPED STONE: 9" x 7"

USED DRILL HOLE.



MISC. INFORMATION

FD RAILROAD SPIKE 0.32' BELOW SURFACE. TIED
W/ CROSS TIES AND DUG FOR STONE. RAILROAD
SPIKE WAS 0.07' WEST AND 0.05' SOUTH OF DRILL
HOLE.

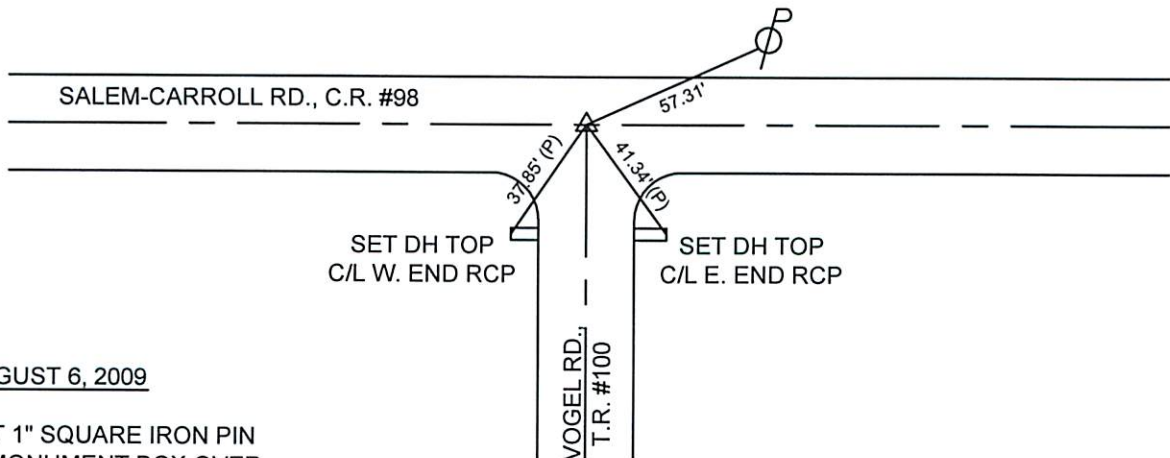

AUGUST 6, 2009

SET 1" SQUARE IRON PIN
IN MONUMENT BOX OVER
STONE