

OTTAWA COUNTY ENGINEERS OFFICE

REFERENCE NO. 31-7-15-E
CENTER POST SECTION 31
SALEM TWP.
SHEET 1 OF 1.

ROUTE: T-100 VOGEL RD.

TOWNSHIP: SALEM

SECTION: 31

T 7 N R 15 E.

PERSONNEL:

M. WITTMAN, P.S.
J. ALLEN
S. ULLRICH
M. ULLRICH


NORTHING:

EASTING:

DATE / WEATHER / TEMP:

JUNE 26, 2008
SUNNY S - HUMID
83° F

DATUM:

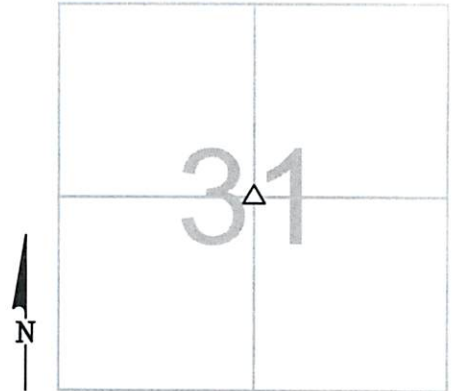

MONUMENT INFORMATION

MONUMENT TYPE: FD LIMESTONE W/ DEPRESSION
ON SURFACE - BELOW: 1.31'
LEFT - CL PAVT - RIGHT:

RECTANGULAR STONE: 4" x 8"

SET DRILL HOLE IN CENTER OF DEPRESSION



MISC. INFORMATION

FD RAILROAD SPIKE ON SURFACE. TIED RAILROAD
SPIKE WITH SHORT TIES. DUG FOR STONE.
RAILROAD SPIKE WAS 0.27' SOUTHWEST OF
CENTER OF STONE.

JUNE 26, 2008

SET 1" SQUARE IRON PIN
IN MONUMENT BOX OVER
STONE

