

OTTAWA COUNTY ENGINEERS OFFICE

REFERENCE NO. 31-7-15-H
SOUTH QUARTER POST SEC. 31
SALEM TWP.
SHEET 1 OF 1.

ROUTE: T-100 VOGEL RD.
@ STATE ROUTE # 163

TOWNSHIP: SALEM

SECTION: 31

T 7 NR 15 E.

PERSONNEL:
M. WITTMAN, P.S.
S. ULLRICH
M. ULLRICH


NORTHING:

EASTING:

DATE / WEATHER / TEMP:

JUNE 26, 2008
SUNNY S
83° F

DATUM:

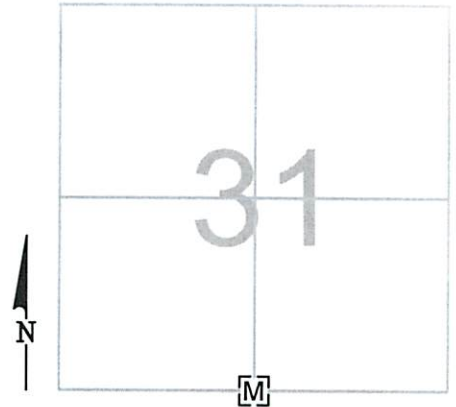

MONUMENT INFORMATION

MONUMENT TYPE: FD 1-1/4" SQ. IRON PIN IN
MONUMENT BOX
ON SURFACE - BELOW:
LEFT - CL PAV'T - RIGHT: 1.5'



MISC. INFORMATION

