

OTTAWA COUNTY ENGINEERS OFFICE

REFERENCE NO. 32-7-15-A
NW CORNER POST SECTION 32
SALEM TWP.
SHEET 1 OF 1.

PERSONNEL:
M. WITTMAN, P.S.
J. ALLEN
C. MILLER

DATE / WEATHER / TEMP:
AUGUST 6, 2009
SUNNY NW
75° F

ROUTE: C-98 SALEM-CARROLL RD. @
T- 92 TOUSSAINT-PORTAGE RD.

TOWNSHIP: SALEM

SECTION: 32

T 7 **N** 15 **E.**

NORTHING:

EASTING:


DATUM:



MONUMENT INFORMATION

MONUMENT TYPE: FD POINTED HARDHEAD STONE
W/ DRILL HOLE
ON SURFACE - BELOW: 2.05'
LEFT - CL PAV'T - RIGHT: 1.91'
RECTANGULAR STONE: 9" x 7"

USED DRILL HOLE.

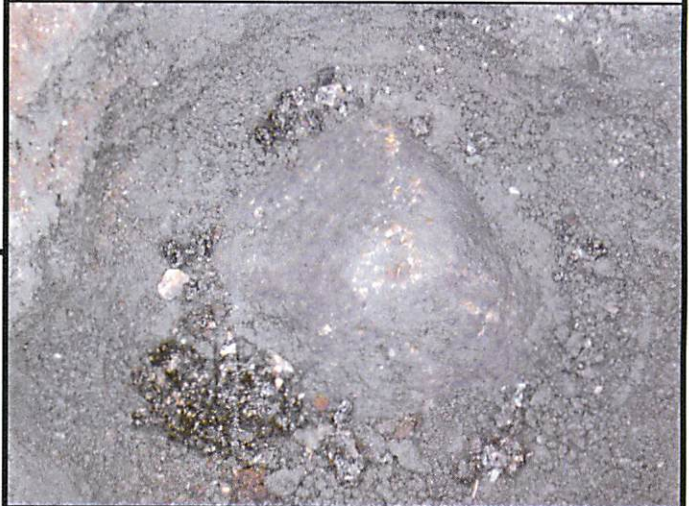

MISC. INFORMATION

FD RAILROAD SPIKE W/ PUNCH MARK ON SURFACE.
TIED W/ CROSS TIES AND DUG FOR STONE.
RAILROAD SPIKE WAS 0.03' NORTH AND 0.02' EAST
OF DRILL HOLE.

AUGUST 6, 2009

SET 1" SQUARE IRON PIN
IN MONUMENT BOX OVER
STONE

