

OTTAWA COUNTY ENGINEERS OFFICE

REFERENCE NO. 32-7-15-G
SW CORNER POST SEC. 32
SALEM TWP.
SHEET 1 OF 1.

ROUTE: T-92 TOUSSAINT - PORTAGE RD.

TOWNSHIP: SALEM

SECTION: 32


T 7 NR 15 E.

PERSONNEL:
M. WITTMAN, P.S.
J. ALLEN
E. KOCH

NORTHING:

EASTING:

DATUM:

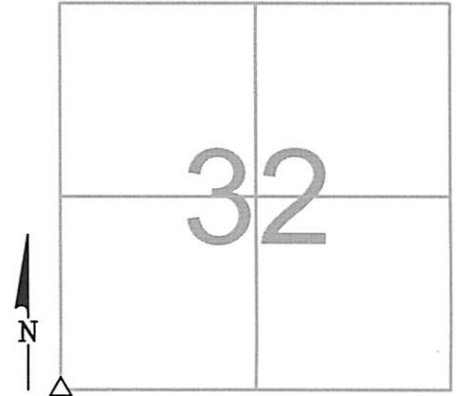

DATE / WEATHER / TEMP:
APRIL 23, 2010
SUNNY
60° F

MONUMENT INFORMATION

MONUMENT TYPE: FD. 5"x5" RECTANGULAR STONE
ON SURFACE - BELOW: 1.56'
LEFT - CL PAV'T - RIGHT: 1.25'

USED CENTER OF STONE



MISC. INFORMATION

FD. PK NAIL WITH 2' TIES ON SURFACE. DUG FOR
STONE. PK NAIL WAS 0.05' W AND 0.08' S OF
CENTER OF STONE. DID NOT FIND IRON PIN PER
D.J. NISSEN ON WAY TO STONE.

APRIL 23, 2010

SET 1" SQUARE IRON PIN
IN MONUMENT BOX OVER
STONE

