

OTTAWA COUNTY ENGINEERS OFFICE

REFERENCE NO. 33-7-15-C
 NE CORNER POST SECTION 33
 SALEM TWP.
 SHEET 1 OF 1.

ROUTE: C-98 SSALEM-CARROLL RD.

TOWNSHIP: SALEM

SECTION: 33

T 7 NR 15 E.

PERSONNEL:

M. WITTMAN, P.S.
 J. ALLEN
 C. MILLER


NORTHING:

EASTING:

DATE / WEATHER / TEMP:

AUGUST 10, 2009
 SUNNY HUMID SW
 90° F

DATUM:

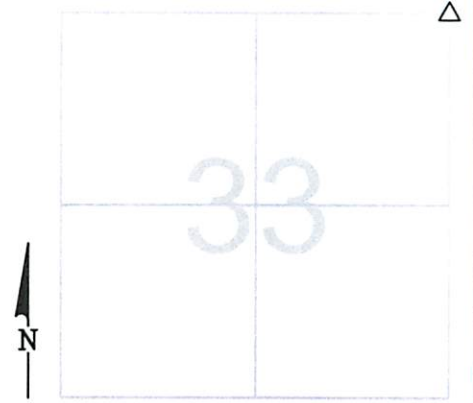

MONUMENT INFORMATION

MONUMENT TYPE: FD POINTED LIMESTONE
 ON SURFACE - BELOW: 2.04'
 LEFT - CL PAV'T - RIGHT: 2.15'
 RECTANGULAR STONE: 2" x 4" TOP

 USED HIGHPOINT OF STONE.



MISC. INFORMATION

FD PK NAIL ON SURFACE. TIED W/ CROSS TIES AND
 DUG FOR STONE. PK NAIL WAS 0.10' SOUTH AND
 0.12' WEST OF HIGH POINT OF STONE.

