

OTTAWA COUNTY ENGINEERS OFFICE

REFERENCE NO. 33-7-15-F
EAST QUARTER POST SEC. 33
SALEM TWP.
SHEET 1 OF 1.

ROUTE: T-102 BEHLMAN RD.

TOWNSHIP: SALEM

SECTION: 33

T 7 NR 15 E.

PERSONNEL:
M. WITTMAN, P.S.
J. ALLEN


NORTHING:

EASTING:

DATUM:

DATE / WEATHER / TEMP:

JUNE 13, 2016
SUNNY - E
81° F

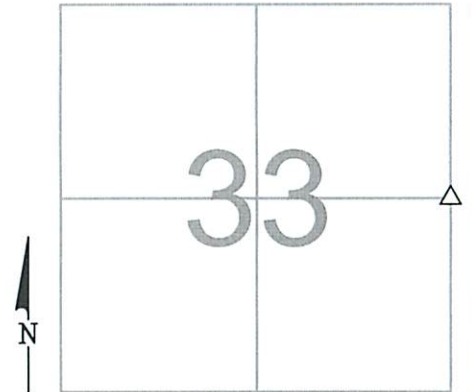

MONUMENT INFORMATION

MONUMENT TYPE: FD. TRIANGULAR STONE
ON SURFACE - BELOW: 1.46'
LEFT - CL PAV'T - RIGHT: 4.70'

8" x 12" TRIANGULAR SHAPED STONE.

USED CENTER OF STONE.



MISC. INFORMATION

FD PK NAIL 0.15' BELOW SURFACE, TIED W/
X-TIES AND DUG FOR STONE. PK NAIL WAS 0.05'
WEST AND 0.05' SOUTH OF CENTER OF STONE.

JUNE 13, 2016

SET 1" SQUARE IRON PIN
IN MONUMENT BOX OVER
STONE

