

OTTAWA COUNTY ENGINEERS OFFICE

REFERENCE NO. 33-7-15-1
SE CORNER POST SECTION 33
SALEM TWP.
SHEET 1 OF 1.

ROUTE: T-102 BEHLMAN RD.

TOWNSHIP: SALEM

SECTION: 33

T 7 NR 15 E.


PERSONNEL:

MIKE WITTMAN, P.S.
J. D. BARNES
K. SMITH
S. ULLRICH

NORTHING:

EASTING:

DATUM:

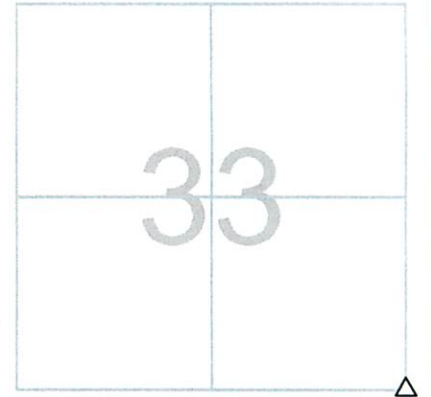

DATE / WEATHER / TEMP:

JUNE 27, 2006
SUNNY & HUMID
81° F

MONUMENT INFORMATION

MONUMENT TYPE: FD STONE
ON SURFACE - BELOW: 1.65'
LEFT - CL PAV'T - RIGHT: 6.45'
RECTANGULAR STONE: 4.5" E-W x 5.5" N-S

FLAT SANDSTONE WITH PLUS (+) ETCHED IN SURFACE.



MISC. INFORMATION

JUNE 27, 2006

SET 1" SQUARE IRON PIN
IN MONUMENT BOX OVER
STONE

