

# OTTAWA COUNTY ENGINEERS OFFICE

REFERENCE NO. 34-7-15-D  
WEST QUARTER POST SEC. 34  
SALEM TWP.  
SHEET 1 OF 1.

ROUTE: T-102 BEHLMAN RD.

TOWNSHIP: SALEM

SECTION: 34

T 7 N R 15 E.

PERSONNEL:  
M. WITTMAN, P.S.  
J. ALLEN


NORTHING:

EASTING:

DATUM:

DATE / WEATHER / TEMP:

JUNE 13, 2016  
SUNNY - E  
81° F

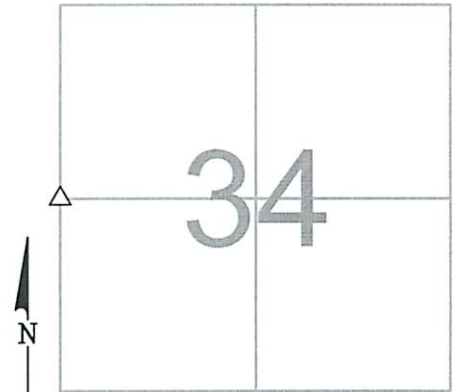

## MONUMENT INFORMATION

MONUMENT TYPE: FD. TRIANGULAR STONE  
ON SURFACE - BELOW: 1.46'  
LEFT - CL PAV'T - RIGHT: 4.70'

8" x 12" TRIANGULAR SHAPED STONE.

USED CENTER OF STONE.



## MISC. INFORMATION

FD PK NAIL 0.15' BELOW SURFACE, TIED W/  
X-TIES AND DUG FOR STONE. PK NAIL WAS 0.05'  
WEST AND 0.05' SOUTH OF CENTER OF STONE.

JUNE 13, 2016

SET 1" SQUARE IRON PIN  
IN MONUMENT BOX OVER  
STONE

