

# OTTAWA COUNTY ENGINEERS OFFICE

REFERENCE NO. 34-7-15-F  
EAST QUARTER POST SEC. 34  
SALEM TWP.  
SHEET 1 OF 1.

PERSONNEL:  
M. WITTMAN, P.S.  
J. ALLEN  
J. TIMMONS

DATE / WEATHER / TEMP:  
MAY 13, 2016  
SUNNY - NW  
67° F

ROUTE: T-101 LEUTZ RD.  
@ LaCARPE CREEK

TOWNSHIP: SALEM


SECTION: 34

T 7 NR 15 E.

NORTHING:

EASTING:

DATUM:

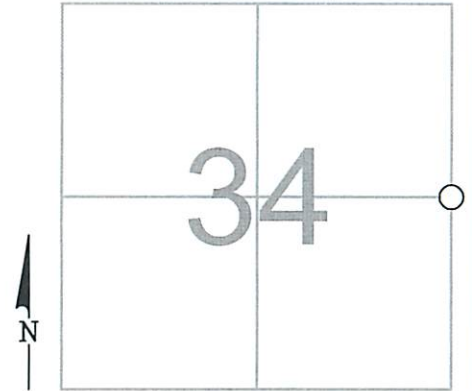

## MONUMENT INFORMATION

MONUMENT TYPE: FD. 7/8" Ø IRON PIN  
ON SURFACE - BELOW: 1.17'  
LEFT - CL PAV'T - RIGHT: 0.70'

IRON PIN PER COUNTY CORNER RECORDS.



## MISC. INFORMATION

FD PK NAIL ON SURFACE W/ 2' TIES NROTH, EAST  
AND WEST. TIED W/ X-TIES AND DUG FOR PIN OF  
RECORD. PK NAIL WAS ONLINE EAST AND WEST  
AND 0.05' N OF CENTER OF PIN.  
PLACE A 12" SQUARE SLEEVE OVER PIN AND A 1"  
x 7" SQUARE EXTENSION PIN IN MONUMENT BOX.

MAY 13, 2016

SET 1" SQUARE EXTENSION  
IRON PIN IN MONUMENT BOX  
OVER 7/8" Ø IRON PIN

