

OTTAWA COUNTY ENGINEERS OFFICE

REFERENCE NO. 35-7-15-B
NORTH QUARTER POST SEC. 35
SALEM TWP.
SHEET 1 OF 1.

ROUTE: C-98 SALEM-CARROLL RD.

TOWNSHIP: SALEM

SECTION: 35

T 7 NR 15 E.


PERSONNEL:

M. WITTMAN, P.S.
J. ALLEN
E. KOCH
C. MILLER

NORTHING:

EASTING:

DATUM:

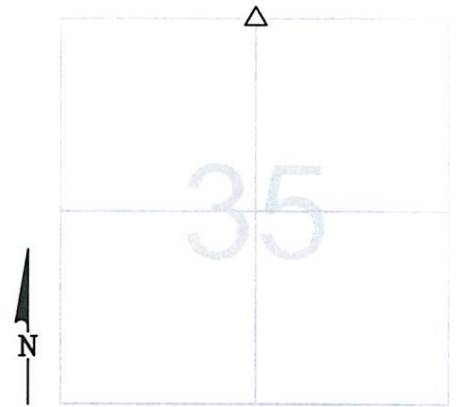

DATE / WEATHER / TEMP:

AUGUST 13, 2009
SUNNY E
76° F

MONUMENT INFORMATION

MONUMENT TYPE: FD LIMESTONE W/ DRILL HOLE
ON SURFACE - BELOW: 1.98'
LEFT - CL PAV'T - RIGHT: 1.75'
RECTANGULAR STONE: 7 1/2" x 5"

USED DRILL HOLE.



MISC. INFORMATION

AUGUST 13, 2009

SET 1" SQUARE IRON PIN
IN MONUMENT BOX OVER
STONE

