

OTTAWA COUNTY ENGINEERS OFFICE

REFERENCE NO. 35-7-15-E
CENTER POST SEC. 35
SALEM TWP.
SHEET 1 OF 1.

ROUTE: T-103 ATWATER RD.

TOWNSHIP: SALEM

SECTION: 35

T 7 NR 15 E.


NORTHING:

EASTING:

DATUM:

PERSONNEL:
M. WITTMAN, P.S.
J. ALLEN

DATE / WEATHER / TEMP:
MAY 17, 2012
SUNNY E
65° F

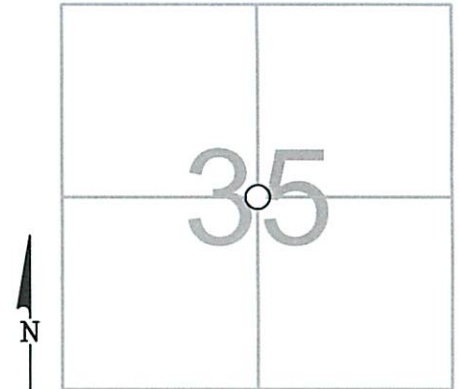

MONUMENT INFORMATION

MONUMENT TYPE: FD. 1-1/4" Ø IRON PIN
ON SURFACE - BELOW: 0.65'
LEFT - CL PAV'T - RIGHT: 3.20'



MISC. INFORMATION

FD. IRON PIN PER COUNTY RECORDS.

MAY 17, 2012

SET MONUMENT BOX OVER
1-1/4" Ø IRON PIN

