

# OTTAWA COUNTY ENGINEERS OFFICE

REFERENCE NO. 35-7-15-H  
SOUTH QUARTER POST SEC. 35  
SALEM TWP.  
SHEET 1 OF 1.

ROUTE: T-103 ATWATER RD.

TOWNSHIP: SALEM

SECTION: 35

T 7 NR 15 E.

PERSONNEL:  
M. WITTMAN, P.S.  
J. ALLEN


NORTHING:

EASTING:

DATUM:

DATE / WEATHER / TEMP:

MAY 18, 2012  
SUNNY N-NE  
70° F

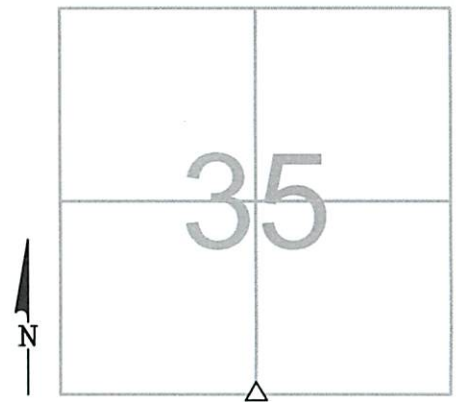

## MONUMENT INFORMATION

MONUMENT TYPE: FD. 4-1/2" X 3" LIMESTONE  
ON SURFACE - BELOW: 1.25'  
LEFT - CL PAV'T - RIGHT: 1.40'

TRIANGULAR STONE

USED CENTER OF STONE



## MISC. INFORMATION

STONE SURROUNDED BY METAL PLATES

MAY 18, 2012

SET 1" SQUARE IRON PIN  
IN MONUMENT BOX OVER  
STONE

