

OTTAWA COUNTY ENGINEERS OFFICE

REFERENCE NO. 36-7-15-B
NORTH QUARTER POST SEC. 36
SALEM TWP.
SHEET 1 OF 1.

ROUTE: C-98 SALEM-CARROLL RD.
@ T-105 BROKATE RD.

TOWNSHIP: SALEM

SECTION: 36

T 7 NR 15 E.

PERSONNEL:
M. WITTMAN, P.S.
J. ALLEN
C. MILLER


NORTHING:

EASTING:

DATUM:

DATE / WEATHER / TEMP:

NOVEMBER 9, 2012
SUNNY
38° F

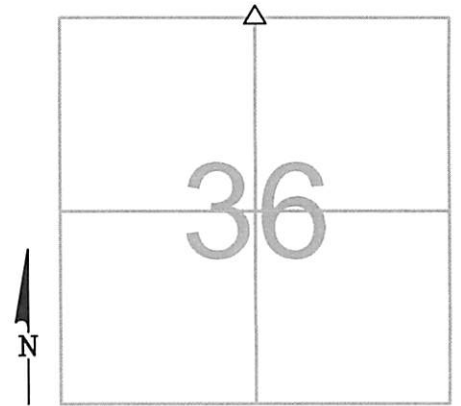


MONUMENT INFORMATION

MONUMENT TYPE: FD. LIMESTONE W/ DH
ON SURFACE - BELOW: 2.00'
LEFT - CL PAV'T - RIGHT:

IRREGULAR SHAPED STONE 3"x5"x10"

USED DRILL HOLE

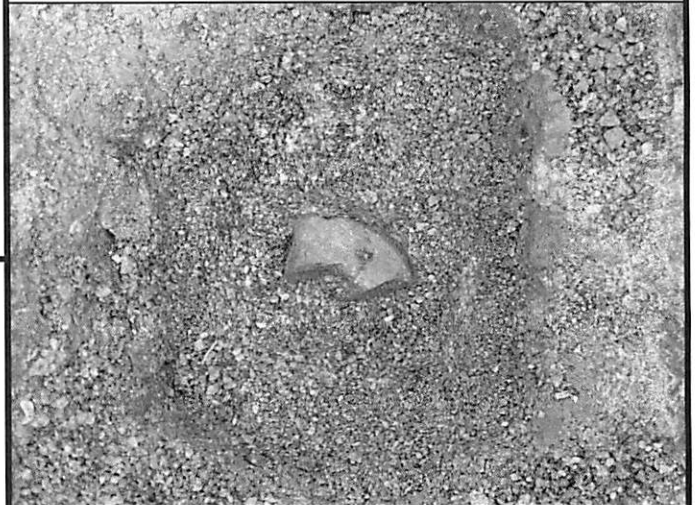

MISC. INFORMATION

FD. RAILROAD SPIKE 0.54' BELOW SURFACE, TIED
WITH X-TIES AND DUG FOR STONE. RAILROAD
SPIKE HAD A SLIGHT SW LEAN AND WAS 0.04' W
AND 0.02' S OF DRILL HOLE IN STONE.

NOVEMBER 9, 2012

SET 1" SQUARE IRON PIN
IN MONUMENT BOX OVER
STONE

