

OTTAWA COUNTY ENGINEERS OFFICE

REFERENCE NO. 36-7-15-C
 NE CORNER POST SEC. 36
 SALEM TWP.
SHEET 1 **OF** 1

ROUTE: C-98 SALEM-CARROLL RD.
 @ C-26 CARROLL-ERIE RD.

TOWNSHIP: SALEM

SECTION: 36

T 7 **N** 15 **E.**


NORTHING:

EASTING:

DATUM:

PERSONNEL:
 M. WITTMAN, P.S.
 J. ALLEN
 C. MILLER

DATE / WEATHER / TEMP:
 NOVEMBER 9, 2012
 SUNNY
 53° F

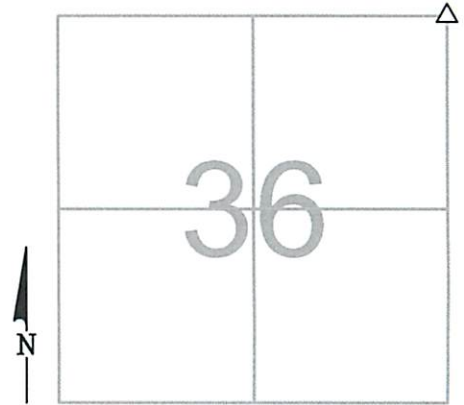

MONUMENT INFORMATION

MONUMENT TYPE: FD. HARDHEAD STONE
 ON SURFACE - BELOW: 1.63'
LEFT - CL PAV'T - RIGHT: 3.00'

6-1/2" x 4" RECTANGULAR STONE
 USED HIGH POINT OF STONE



MISC. INFORMATION

FD. RAILROAD SPIKE 0.21' BELOW SURFACE, TIED
 W/ X-TIES AND DUG FOR STONE. RAILROAD SPIKE
 WAS 0.14' W AND 0.05' S OF HIGH POINT AND WAS
 BARELY OVER ANY PART OF STONE.

NOVEMBER 9, 2012

SET 1" SQUARE IRON PIN
 IN MONUMENT BOX OVER
 STONE

