

OTTAWA COUNTY ENGINEERS OFFICE

REFERENCE NO. 36-7-15-D
WEST QUARTER POST SEC. 36
SALEM TWP.
SHEET 1 OF 1.

ROUTE: C-104 TOUSSAINT SOUTH RD.

TOWNSHIP: SALEM

SECTION: 36

T 7 N R 15 E.


PERSONNEL:
M. WITTMAN, P.S.
J. ALLEN
M. ULLRICH

NORTHING:

EASTING:

DATE / WEATHER / TEMP:
AUGUST 1, 2008
SUNNY - HOT
88° F

DATUM:

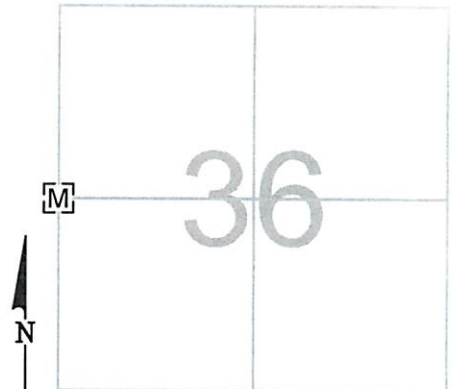

MONUMENT INFORMATION

MONUMENT TYPE: FD 5/8" IRON PIN IN
MONUMENT BOX
ON SURFACE - BELOW: 0.23'
LEFT - CL PAV'T - RIGHT: 5.55'



MISC. INFORMATION

