

OTTAWA COUNTY ENGINEERS OFFICE

REFERENCE NO. 36-7-15-F
EAST QUARTER POST SEC. 36
SALEM TWP.
SHEET 1 OF 1.

ROUTE: C-26 CARROLL - ERIE RD.

TOWNSHIP: SALEM

SECTION: 36

T 7 NR 15 E.


PERSONNEL:
M. WITTMAN, P.S.
J. ALLEN
M. ULLRICH
S. ULLRICH

NORTHING:

EASTING:

DATUM:

DATE / WEATHER / TEMP:
JUNE 27, 2008
SUNNY S-SW
76° F

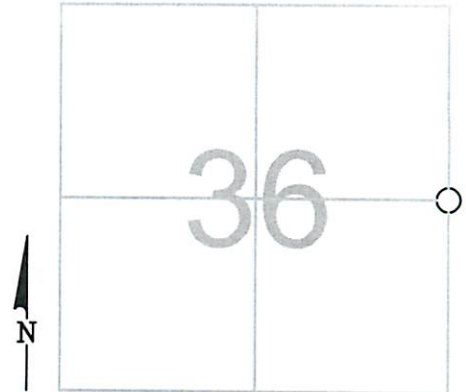

MONUMENT INFORMATION

MONUMENT TYPE: FD 1" SQUARE IRON PIN
ON SURFACE - BELOW: 0.27'
LEFT - CL PAV'T - RIGHT: 1.50'



MISC. INFORMATION

JUNE 27, 2008

SET MONUMENT BOX OVER
IRON PIN

CARROLL-ERIE RD.,
C.R. #26
12.61'



FD STONE
W 1/4 POST
SEC. 31
ERIE TWP