

OTTAWA COUNTY ENGINEERS OFFICE

REFERENCE NO. 36-7-15-G
SW CORNER SECTION 36
SALEM TWP.
SHEET 1 OF 1.

ROUTE: C-104 TOUSSAINT SOUTH RD.

TOWNSHIP: SALEM

SECTION: 36

T 7 N R 15 E.


PERSONNEL:

J. ALLEN
B. JEFFRIES
S. ULLRICH
M. ULLRICH

NORTHING:

EASTING:

DATUM:

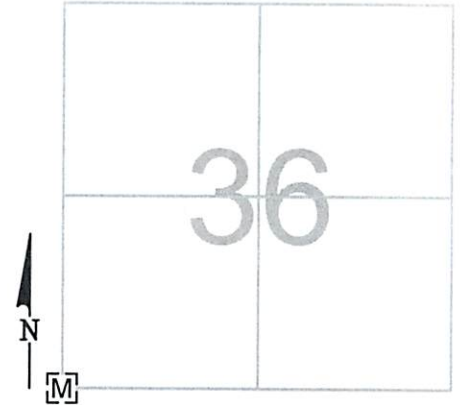

DATE / WEATHER / TEMP:

AUGUST 5, 2008
OVERCAST
75° F

MONUMENT INFORMATION

MONUMENT TYPE: FD STONE W/ DRILL HOLE IN
MONUMENT BOX
ON SURFACE - BELOW: 1.11'
LEFT - CL PAV'T - RIGHT: 1.85'



MISC. INFORMATION

AUGUST 5, 2008

RAISED TO SURFACE

