

OTTAWA COUNTY ENGINEERS OFFICE

REFERENCE NO. 4-6-15-C
NE CORNER SECTION 4
SALEM TWP.
SHEET 1 OF 1.

ROUTE: T-102 BEHLMAN RD.

TOWNSHIP: SALEM

SECTION: 4

T 6 NR 15 E.

PERSONNEL:

M. WITTMAN, P.S.
J. ALLEN


NORTHING:

EASTING:

DATE / WEATHER / TEMP:

DECEMBER 4, 2008
OVERCAST NW
33° F

DATUM:

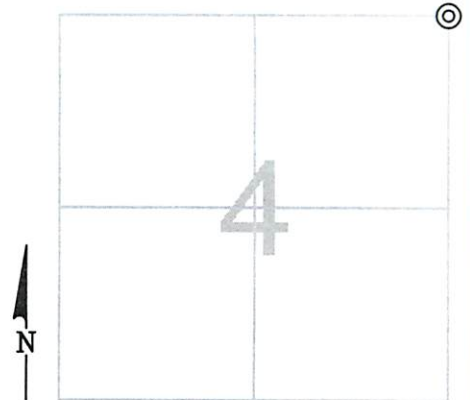

MONUMENT INFORMATION

MONUMENT TYPE: FD 1" Ø IRON PIPE IN 4" PVC
ON SURFACE - BELOW: 0.79' (PIPE)
LEFT - CL PAV'T - RIGHT: 12.70'

PVC IS AT SURFACE WITH CAP

THIS IS A CLOSING CORNER



MISC. INFORMATION

