

# OTTAWA COUNTY ENGINEERS OFFICE

REFERENCE NO. 5-6-15-A  
NW CORNER POST SEC. 5  
SALEM TWP.  
SHEET 1 OF 1.

PERSONNEL:  
M. WITTMAN, P.S.  
J. ALLEN  
E. KOCH

DATE / WEATHER / TEMP:  
APRIL 23, 2010  
SUNNY  
60° F

ROUTE: T-92 TOUSSAINT - PORTAGE RD.

TOWNSHIP: SALEM


SECTION: 5

T 7 NR 15 E.

NORTHING:

EASTING:

DATUM:

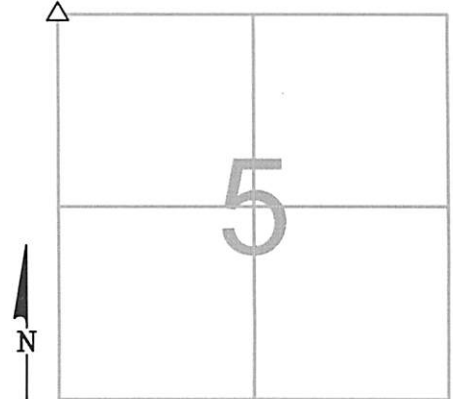

## MONUMENT INFORMATION

MONUMENT TYPE: FD. 5"x5" RECTANGULAR STONE  
ON SURFACE - BELOW: 1.56'  
LEFT - CL PAV'T - RIGHT: 1.25'

USED CENTER OF STONE



## MISC. INFORMATION

FD. PK NAIL WITH 2' TIES ON SURFACE. DUG FOR  
STONE. PK NAIL WAS 0.05' W AND 0.08' S OF  
CENTER OF STONE. DID NOT FIND IRON PIN PER  
D.J. NISSEN ON WAY TO STONE.

APRIL 23, 2010

SET 1" SQUARE IRON PIN  
IN MONUMENT BOX OVER  
STONE

