

# OTTAWA COUNTY ENGINEERS OFFICE

REFERENCE NO. 5-6-15-D  
WEST QUARTER POST SEC. 5  
SALEM TWP.  
SHEET 1 OF 1.

PERSONNEL:  
M. WITTMAN, P.S.  
J. ALLEN

DATE / WEATHER / TEMP:  
MAY 22, 2015  
SUNNY - N  
67° F

ROUTE: T-92 TOUSSANT PORTAGE RD.

TOWNSHIP: SALEM


SECTION: 5

T 6 NR 15 E.

NORTHING:

EASTING:

DATUM:

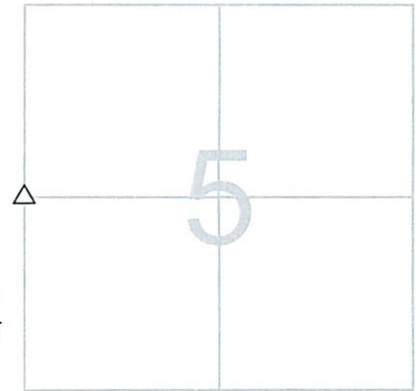

## MONUMENT INFORMATION

MONUMENT TYPE: FD 10"x9" HARDHEAD STONE  
ON SURFACE - BELOW: 1.56'  
LEFT - CL PAV'T - RIGHT: 1.10'

TRIANGULAR SHAPED STONE

USED CENTER OF STONE



## MISC. INFORMATION

FD PK NAIL 0.34' BELOW SURFACE, TIED W/ X-TIES  
AND DUG FOR STONE.

PK NAIL WAS OVER CENTER OF STONE

STONE WITNESSED BY: RAYMOND VELLIQUETTE &  
RYAN NUHFER, P.S.

MAY 22, 2015

SET 1" SQUARE IRON PIN  
IN MONUMENT BOX OVER  
STONE

