

OTTAWA COUNTY ENGINEERS OFFICE

REFERENCE NO. 6-6-15-B
NORTH QUARTER POST SEC. 6
SALEM TWP.
SHEET 1 OF 1.

ROUTE: T-100 VOGEL RD.
@ STATE ROUTE # 163

TOWNSHIP: SALEM

SECTION: 6

T 6 NR 15 E.


NORTHING:

EASTING:

DATUM:

PERSONNEL:
M. WITTMAN, P.S.
S. ULLRICH
M. ULLRICH

DATE / WEATHER / TEMP:
JUNE 26, 2008
SUNNY S
83° F

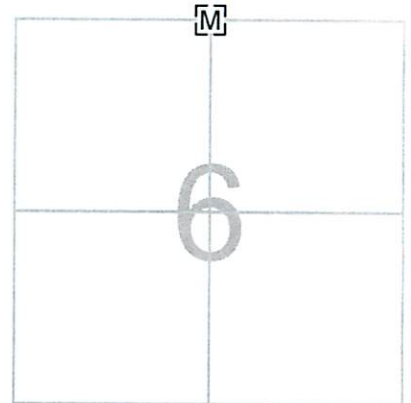

MONUMENT INFORMATION

MONUMENT TYPE: FD 1-1/4" SQ. IRON PIN IN
MONUMENT BOX
ON SURFACE - BELOW:
LEFT - CL PAV'T - RIGHT: 1.5'



MISC. INFORMATION

