

OTTAWA COUNTY ENGINEERS OFFICE

REFERENCE NO. 6-6-15-D
 WEST QUARTER POST SEC 6
 SALEM TWP.
 SHEET 1 OF 1.

ROUTE: C-23 BENTON CARROLL RD.

TOWNSHIP: SALEM

SECTION: 6


T 6 NR 15 E.

PERSONNEL:
 M. WITTMAN, P.S.
 J. ALLEN
 J. LAUBACHER

NORTHING:

EASTING:

DATUM:

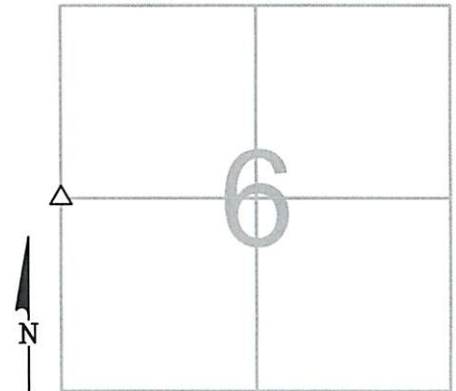

DATE / WEATHER / TEMP:
 AUGUST 5, 2011
 SUNNY
 79° F

MONUMENT INFORMATION

MONUMENT TYPE: FD 12" X 10 1/2" SANDSTONE
 ON SURFACE - BELOW: 1.41'
LEFT - CL PAV'T - RIGHT: 1.0'



MISC. INFORMATION

FD RR SPK 0.38' BELOW SURFACE
 TIED W/ X-TIES & DUG FOR STONE
 USED CENTER OF STONE

THIS IS A CLOSING CORNER

AUGUST 5, 2011

SET 1" SQUARE IRON PIN
 IN MONUMENT BOX OVER
 STONE

