

OTTAWA COUNTY ENGINEERS OFFICE

REFERENCE NO. 6-6-15-F
EAST QUARTER POST SEC. 6
SALEM TWP.
SHEET 1 OF 1.

PERSONNEL:
M. WITTMAN, P.S.
J. ALLEN

DATE / WEATHER / TEMP:
MAY 22, 2015
SUNNY - N
67° F

ROUTE: T-92 TOUSSANT PORTAGE RD.

TOWNSHIP: SALEM


SECTION: 6

T 6 NR 15 E.

NORTHING:

EASTING:

DATUM:

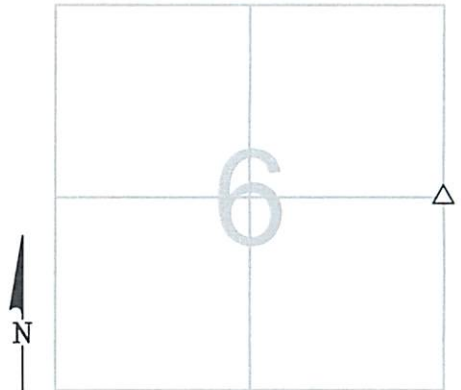

MONUMENT INFORMATION

MONUMENT TYPE: FD 10"x9" HARDHEAD STONE
ON SURFACE - BELOW: 1.56'
LEFT - CL PAV'T - RIGHT: 1.10'

TRIANGULAR SHAPED STONE

USED CENTER OF STONE



MISC. INFORMATION

FD PK NAIL 0.34' BELOW SURFACE, TIED W/ X-TIES
AND DUG FOR STONE.

PK NAIL WAS OVER CENTER OF STONE

STONE WITNESSED BY: RAYMOND VELLIQUETTE &
RYAN NUHFER, P.S.

MAY 22, 2015

SET 1" SQUARE IRON PIN
IN MONUMENT BOX OVER
STONE

