


OTTAWA COUNTY ENGINEERS OFFICE

REFERENCE NO. 6-6-15-G
 SW CORNER POST SECTION 6
 SALEM TWP.
 SHEET 1 OF 1.

ROUTE: C-23 BENTON CARROLL RD.
 TOWNSHIP: SALEM
 SECTION: 6
 T 6 NR 15 E.

PERSONNEL:
 M. WITTMAN, P.S.
 J. ALLEN
 J. LAUBACHER

NORTHING:
 EASTING:
 DATUM:

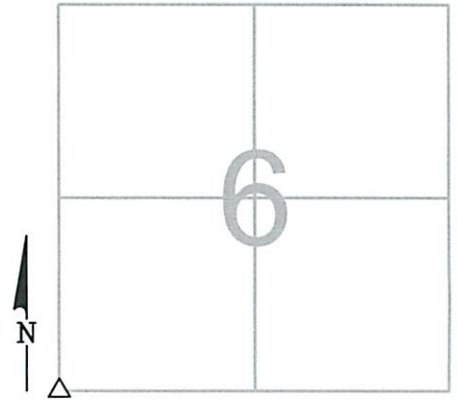

DATE / WEATHER / TEMP:
 JULY 28, 2011
 SUNNY HUMID
 82° F

MONUMENT INFORMATION

MONUMENT TYPE: FD 10" X 9" LIMESTONE W/ DH
 ON SURFACE - BELOW: 1.45'
LEFT - CL PAV'T - RIGHT: 4'
 NW CORNER OF STONE GONE



MISC. INFORMATION

FD 1" Ø PIN 0.68' BELOW SURFACE
 TIED W/ X-TIES & DUG FOR STONE
 1" Ø PIN WAS OFFSET PIN SIMILAR TO OCE PIN
 CENTER OF 1" PIN WAS .03' W & .06' N OF DRILL
 HOLE
 REMOVED OLD PIN
 USED DRILL HOLE

THIS IS A CLOSING CORNER

JULY 28, 2011

SET 1" SQUARE IRON PIN
 IN MONUMENT BOX OVER
 DH IN STONE

