


OTTAWA COUNTY ENGINEERS OFFICE

REFERENCE NO. 7-6-15-H
 SOUTH QUARTER POST SEC. 7
 SALEM TWP.
 SHEET 1 OF 1.

ROUTE: T-41 FOUR-MILE HOUSE RD.
 TOWNSHIP: SALEM
 SECTION: 7
 T 6 NR 15 E.

PERSONNEL:
 M. WITTMAN, P.S.
 J. ALLEN
 J. HAYES - BEC
 M. POMMERANZ - BEC

NORTHING:
 EASTING:
 DATUM:

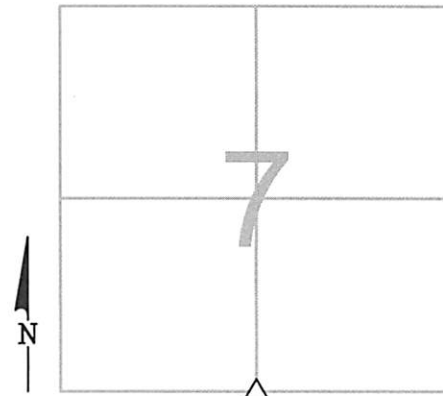

DATE / WEATHER / TEMP:
 JUNE 25, 2012
 SUNNY - NE
 70° F

MONUMENT INFORMATION

MONUMENT TYPE: FD POINTED HARDHEAD STONE
 ON SURFACE - BELOW: 1.92'
LEFT - CL PAV'T - RIGHT: 3.10'

 STONE WAS 5" X 7" X 11-1/2"

 USED POINT OF STONE



MISC. INFORMATION

FD PK NAIL 0.45' BELOW SURFACE. TIED W/ X-TIES
 AND DUG FOR STONE.

 SET FAINT DRILL HOLE IN POINT OF STONE.

JUNE 25, 2012

SET 1" SQUARE IRON PIN
 IN MONUMENT BOX OVER
 STONE

