

# OTTAWA COUNTY ENGINEERS OFFICE

REFERENCE NO. 7-6-15-I  
SOUTHEAST CORNER SEC. 7  
SALEM TWP.  
SHEET 1 OF 1.

ROUTE: T-111 PORTAGE SOUTH RD.  
@ T-107 CULLMAN RD.

TOWNSHIP: SALEM

SECTION: 7

T 6 NR 15 E.

NORTHING:

EASTING:


DATUM:

**PERSONNEL:**

M. WITTMAN, P.S.  
J. ALLEN  
P. LACUMSKY - SALEM TWP.

**DATE / WEATHER / TEMP:**

JUNE 25, 2012  
SUNNY - NE  
76° F

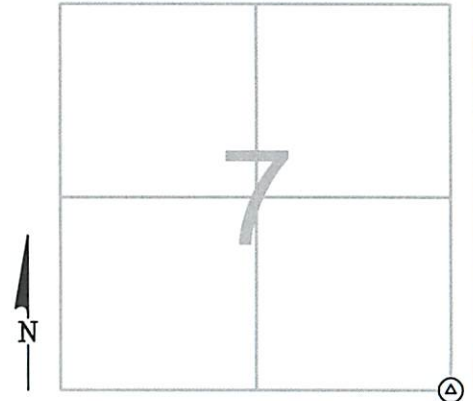

MONUMENT INFORMATION

MONUMENT TYPE: FD BRASS DISK IN CONCRETE  
ON SURFACE - BELOW: 0.85'  
LEFT - CL PAV'T - RIGHT: 1.10'



MISC. INFORMATION

JUNE 25, 2012

SET MONUMENT BOX  
OVER DISK IN CONCRETE

