

# OTTAWA COUNTY ENGINEERS OFFICE

REFERENCE NO. 9-6-15-D  
 WEST QUARTER POST SEC. 9  
 SALEM TWP.  
 SHEET 1 OF 1.

ROUTE: STATE ROUTE #19

TOWNSHIP: SALEM

SECTION: 9

T 6 NR 15 E.


NORTHING:

EASTING:

DATUM:

PERSONNEL:  
 M. WITTMAN, P.S.  
 J. ALLEN

DATE / WEATHER / TEMP:  
 OCTOBER 29, 2013  
 SUNNY - NE  
 50° F

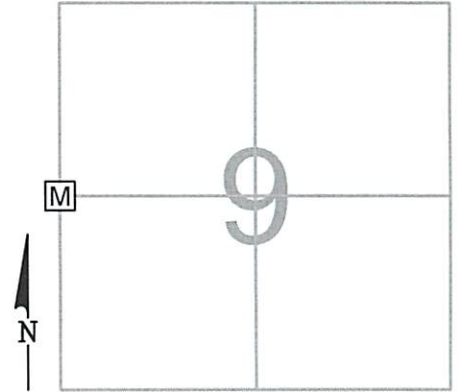

### MONUMENT INFORMATION

MONUMENT TYPE: SET 1" Ø IRON PIN IN MON BOX  
ON SURFACE - BELOW:  
LEFT - CL PAV'T - RIGHT: 8.30'




### MISC. INFORMATION

NO STONE OF RECORD. FD PK NAIL ON SURFACE PER A.W. WEIRICH SURVEY DATED 1-14-2013. ALSO CALCULATED POINT BASED ON 1947 K.E. WEDEKIND SURVEY (BK D PG 27) USING SINGLE PROPORTIONATE MEASURE. WEIRICH POINT WAS 1.00' E AND 0.88' S OF CALCULATED POINT. DUG AT BOTH LOCATIONS, NOTHING FOUND. RECALCULATED POINT BY SINGLE PROPORTIONATE MEASURE BASED ON 1947 SURVEY AND NEW DATA WITH FD IRON PIPE AT NW CORNER SECTION 9. 8-5-14 - SET 1" Ø IRON PIN IN FLOODED SAND IN 6" Ø PVC IN MONUMENT BOX

AGUST 5, 2014

SET 1" Ø IRON PIN IN  
 MONUMENT BOX

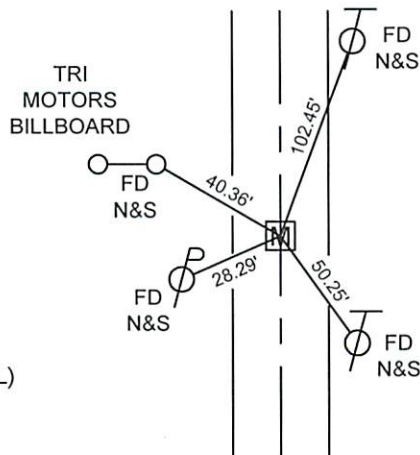

AUGUST 5, 2014 (PERSONNEL)

J. ALLEN -OCE  
 E. WESTFALL, P.S. - ODOT  
 J. LEU, J. THOMAS - ODOT  
 M&B CONSTRUCTION CREW