

OTTAWA COUNTY ENGINEERS OFFICE

REFERENCE NO. 9-6-15-H
SOUTH QUARTER POST SEC. 9
SALEM TWP.
SHEET 1 OF 1.

ROUTE: T-107 CULLMAN RD.

TOWNSHIP: SALEM

SECTION: 9

T 6 NR 15 E.

PERSONNEL:

M. WITTMAN, P.S.
J. ALLEN
B. JEFFRIES


NORTHING:

EASTING:

DATUM:

DATE / WEATHER / TEMP:

JULY 29, 2008
SUNNY HUMID
76° F

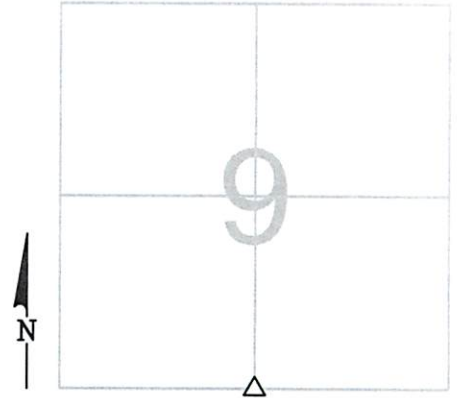

MONUMENT INFORMATION

MONUMENT TYPE: FD POINTED STONE
ON SURFACE - BELOW: 1.50'
LEFT - CL PAV'T - RIGHT: 4.0'

ROUND STONE: 4 1/2" Ø x 7"

USED POINT OF STONE



MISC. INFORMATION

JULY 29, 2008

SET 1" SQUARE IRON PIN
IN MONUMENT BOX OVER
STONE

