

# OTTAWA COUNTY ENGINEERS OFFICE

REFERENCE NO. 13-7-13-A  
 NW CORNER POST SEC. 13  
 ALLEN TWP.  
 SHEET 1 OF 1.

PERSONNEL:  
 M. WITTMAN, P.S.  
 J. ALLEN

DATE / WEATHER / TEMP:  
 AUGUST 20, 2015  
 SUNNY - SW  
 68° F

ROUTE: T-213 OPFER-LENTZ RD.  
 @ T- 67 TROWBRIDGE RD.

TOWNSHIP: ALLEN


SECTION: 13

T 7 NR 13 E.

NORTHING:


EASTING:

DATUM:

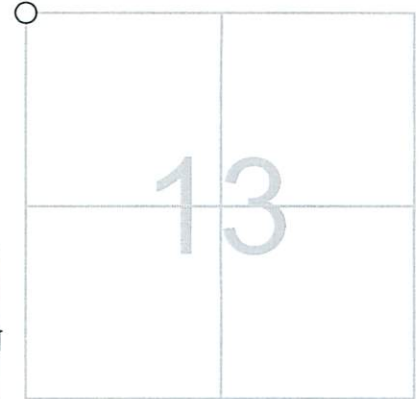

### MONUMENT INFORMATION

MONUMENT TYPE: SET 1" SQ. IRON PIN IN MON BOX  
ON SURFACE - BELOW:  
LEFT - CL PAV'T - RIGHT: 6.00' (OPFER-LENTZ RD)

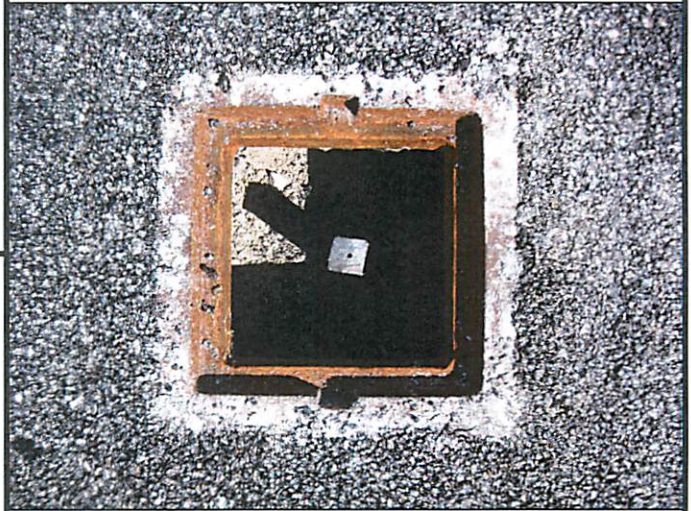

### MISC. INFORMATION

FD. RR SPK ON SURFACE, TIED W/ X-TIES AND  
 DUG FOR STONE. DID NOT FIND A STONE. USED  
 LOCATION OF RR SPK AND SET 1" SQ. IRON PIN  
 IN A MONUMENT BOX.

AUGUST 20, 2015

SET 1" SQUARE IRON PIN  
 IN MONUMENT BOX

