OTTAWA COUNTY ENGINEERS OFFICE

REFERENCE NO. 35-8-13-B
NORTH QUARTER POST SEC. 35
ALLEN TWP.
SHEET 1 **OF** 1.

PERSONNEL:
M. WITTMAN, P.S.
J. ALLEN
M. ULLRICH
S. ULLRICH

DATE / WEATHER / TEMP:
SEPTEMBER 11, 2008
SUNNY S
70° F

ROUTE: T-70 CURTICE E & W RD.

TOWNSHIP: ALLEN

SECTION: 35

T 8 **N R** 13 **E.**

NORTHING:

EASTING:

DATUM:

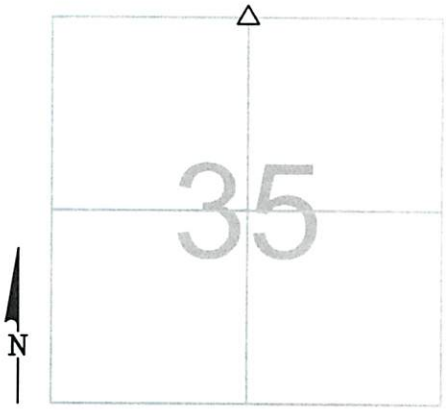

MONUMENT INFORMATION

MONUMENT TYPE: FD. 6"X9" HARDHEAD STONE
W/ SHALLOW DRILL HOLE
ON SURFACE - BELOW: 3.84'
LEFT - CL PAV'T - RIGHT: 1.0'
FD. 1' SQUARE STAKE ON EAST SIDE OF STONE

MISC. INFORMATION

SET 4 EACH 3.0' PK NAIL TIES ON SURFACE
BACKFILLED HOLE TO WITHIN 7 ½" OF SURFACE WITH 411'S, TAMPED IN 6" LIFTS. SET 1" SQUARE IRON PIN WITH STRINGED TIES. USING OPTICAL TRIBRACH SET MONUMENT BOX OVER PIN.

SEPTEMBER 11, 2008
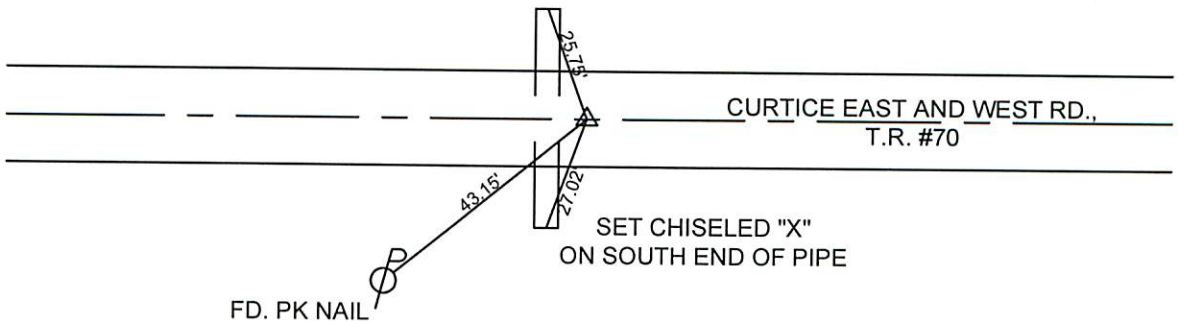
SET 1" SQUARE IRON PIN
IN MONUMENT BOX OVER
STONE