

OTTAWA COUNTY ENGINEERS OFFICE


REFERENCE NO. 16-6-16-E
 CENTER POST SEC. 16
 BAY TWP.
 SHEET 1 OF 1.

ROUTE: T-112 LITTLE-PORTAGE EAST RD.

TOWNSHIP: BAY

SECTION: 16

T 6 NR 16 E.

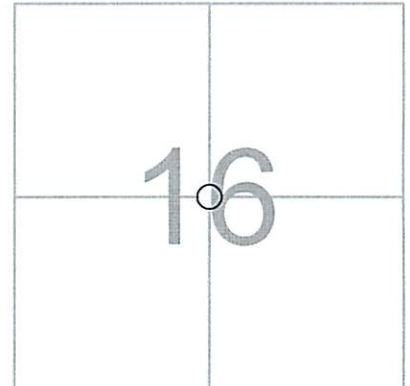

PERSONNEL:
 M. WITTMAN, P.S.
 J. ALLEN

NORTHING:

EASTING:

DATE / WEATHER / TEMP:
 MAY 18, 2017
 SUNNY - SW
 85° F


DATUM:



MONUMENT INFORMATION

MONUMENT TYPE: FD. 1-1/4" Ø IRON PIN
 ON SURFACE - BELOW: 0.37'
LEFT - CL PAV'T - RIGHT: 1.50'

 IRON PIN PER COUNTY RECORDS SET: 10-3-1961.

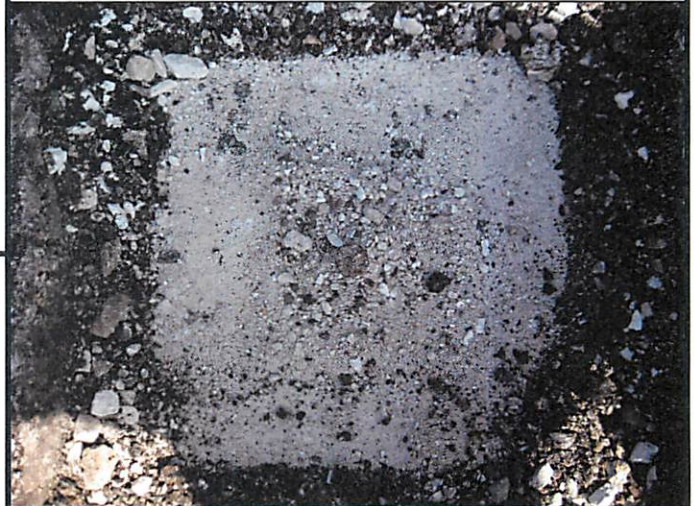

MISC. INFORMATION

MAY 22, 2017

FD. SET MONUMENT BOX OVER
 FD. 1-1/4" Ø IRON PIN

