

OTTAWA COUNTY ENGINEERS OFFICE

REFERENCE NO. 8-7-14-B
NORTH QUARTER POST SEC. 8
BENTON TWP.
SHEET 1 OF 1.

PERSONNEL:
M. WITTMAN, P.S.
J. ALLEN

DATE / WEATHER / TEMP:
JUNE 22, 2015
SUNNY - S
78° F

ROUTE: T-68 WALBRIDGE EAST RD.

TOWNSHIP: BENTON


SECTION: 8

T 7 NR 14 E.

NORTHING:


EASTING:

DATUM:

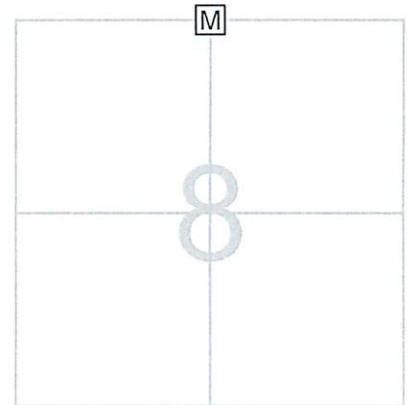

MONUMENT INFORMATION

MONUMENT TYPE: SET 1" SQ IRON PIN IN MON BOX
ON SURFACE - BELOW:
LEFT - CL PAVT - RIGHT: 1.80'

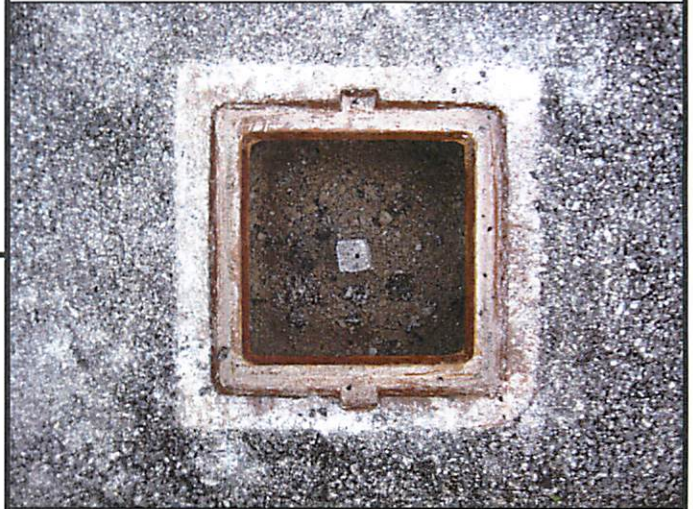

MISC. INFORMATION

FD RR SPK 0.20' BELOW SURFACE, TIED W/ X-TIES
AND DUG FOR STONE OR IRON PIN OF RECORD.
DUG DOWN TO CLAY AND DID NOT FIND A STONE
OR A PIN. SET 1" SQUARE IRON IN MONUMENT BOX
AT LOCATION OF FD RR SPK.

JUNE 22, 2015

SET 1" SQ IRON PIN IN
MONUMENT BOX

