

# OTTAWA COUNTY ENGINEERS OFFICE

REFERENCE NO. 23-7-15-F  
EAST QUARTER POST SEC. 23  
CARROLL TWP.  
SHEET 1 OF 1.

ROUTE: C-104 TOUSSAINT SOUTH RD.  
@ T-96 GENZMAN RD.

TOWNSHIP: CARROLL

SECTION: 23

T 7 NR 15 E.

NORTHING:

EASTING:


DATUM:

**PERSONNEL:**

M. WITTMAN, P.S.  
J. ALLEN  
V. SZABO


**DATE / WEATHER / TEMP:**

MAY 10, 2017  
SUNNY - E  
61° F

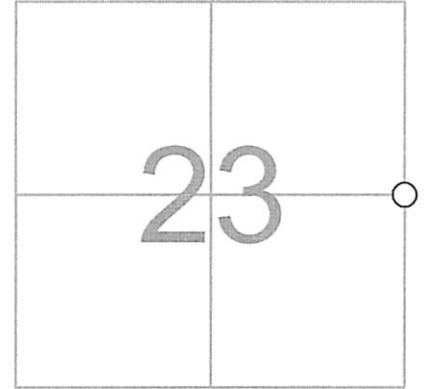

MONUMENT INFORMATION

MONUMENT TYPE: FD. 1" Ø IRON PIN  
ON SURFACE - BELOW: 0.59'  
LEFT - CL PAVT - RIGHT: TOUSSAINT SOUTH ROAD  
LEFT - CL PAVT - RIGHT: 1.90' GENZMAN ROAD  
  
IRON PIN OF RECORD IN STONE BOOK.

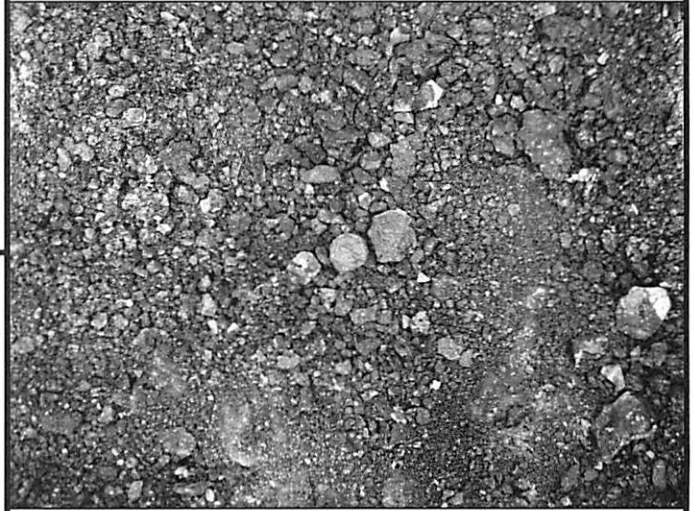

MISC. INFORMATION

FD. RR SPIKE 0.41' BELOW SURFACE, TIED W/  
X-TIES AND DUG FOR PIN OF RECORD.  
RR SPIKE WAS 0.05' SOUTH AND 0.01' EAST OF  
IRON PIN FOUND.

MAY 10, 2017

SET MONUMENT BOX OVER  
1" Ø IRON PIN FOUND

