

OTTAWA COUNTY ENGINEERS OFFICE

REFERENCE NO. 30-7-15-F
 EAST QUARTER POST SEC 30
 CARROLL TWP.

SHEET 1 OF 1.

PERSONNEL:
 M. WITTMAN, P.S.
 J. ALLEN
 J. LAUBACHER

DATE / WEATHER / TEMP:
 JUNE 24, 2011
 OUTCAST W-NW
 65° F

ROUTE: T-92 TOUSSAINT - PORTAGE RD
 @ T-97 BIER

TOWNSHIP: CARROLL


SECTION: 30

T 7 **NR** 15 **E.**

NORTHING:


EASTING:

DATUM:

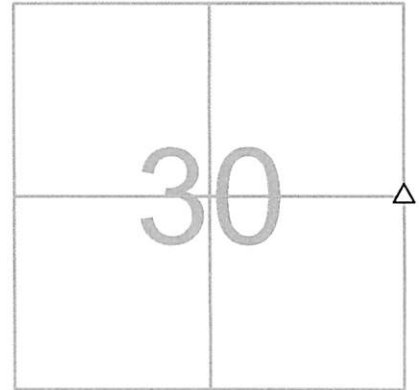

MONUMENT INFORMATION

MONUMENT TYPE: ROUND LIMESTONE W/ DH
 ON SURFACE - BELOW: 1.91'
LEFT - CL PAV'T - RIGHT: 4.50'
 ROUND STONE: 8.5" X 8"

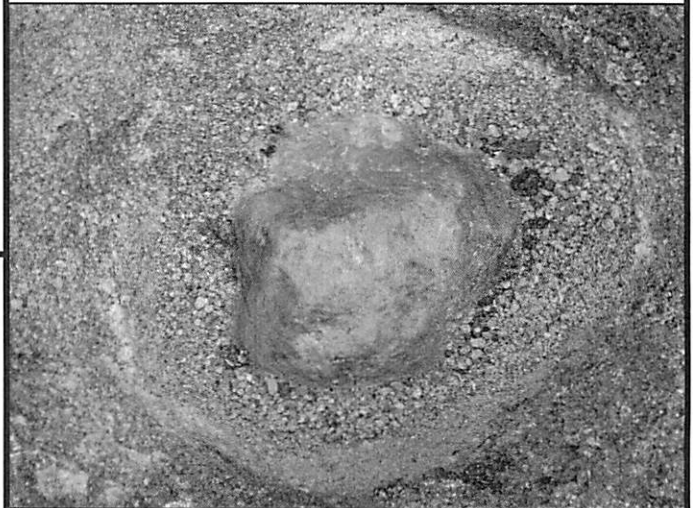

MISC. INFORMATION

FD PK NAIL 0.21' BELOW SURFACE
 TIED W/ X-TIES & DUG FOR STONE
 USED DRILL HOLE
 PK NAIL WAS 0.02' N & 0.01' E OF DRILL HOLE

JUNE 24, 2011

SET 1" SQUARE IRON PIN
 IN MONUMENT BOX OVER
 STONE

