East Pointe at Catawba Bay Condominium
Tenth Amendment

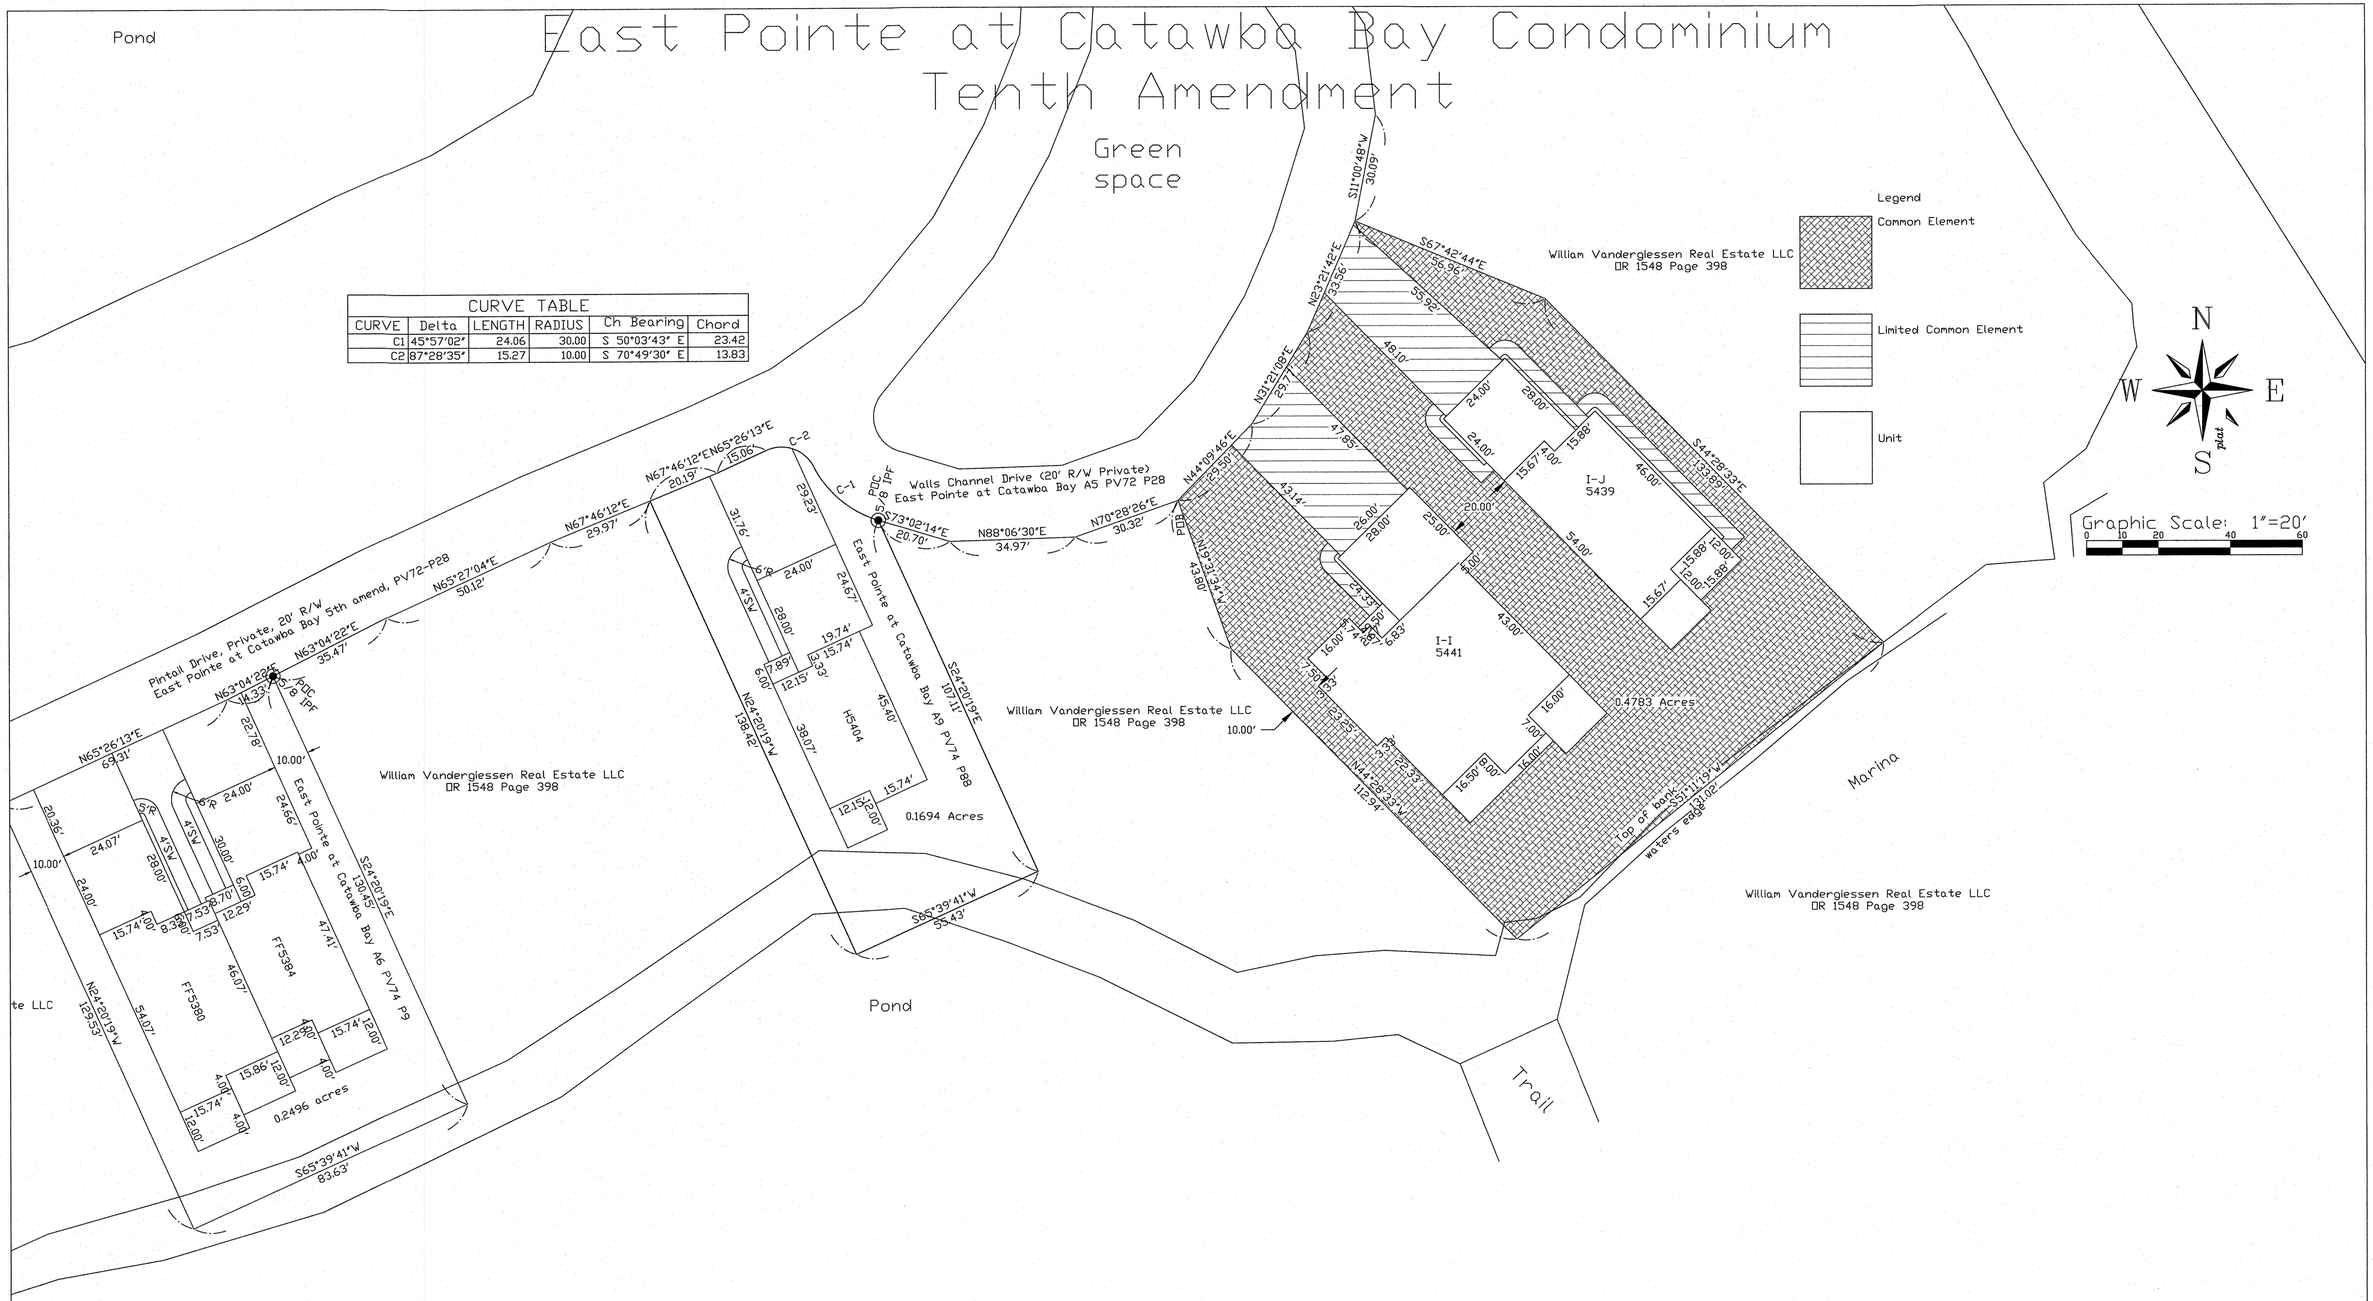

CURVE TABLE					
CURVE	Delta	LENGTH	RADIUS	Ch Bearing	Chord
C1	45°57'02"	24.06	30.00	S 50°03'43" E	23.42
C2	87°28'35"	15.27	10.00	S 70°49'30" E	13.83

Surveyor's Certification
I hereby declare that the drawing accurately reflects the location of improvements and recorded easements to the best of my knowledge and belief.

Engineer's Certification
I hereby declare that the drawing accurately shows each building as built to the best of my knowledge and belief.

202300004233 07/07/2023 11:25 AM
Filed for Record in OTTAWA County, Ohio
Nathan J. Daniels Rec Fees: $245.40
OR Vol 74 Pgs 92 - 94

STATE OF OHIO
Carl M. Feick
S-7035
REGISTERED
PROFESSIONAL SURVEYOR

STATE OF OHIO
Carl M. Feick
52758
REGISTERED
PROFESSIONAL ENGINEER

6/29/2023
Carl M. Feick P.S. 7035

Transferred this 7th Day of July 2023.
Ottawa County Auditor

Recorded this 07th Day of July 2023.
Ottawa County Recorder

CARL M FEICK, P.E. P.S.
712 Bardwell Road, Castalia, Ohio 44824, 419-656-3016

DRAWN BY: CMF DATE: 6/13/2023
JOB NO.: EPACB SHEET 1 OF 1

Tenth Amendment
East Pointe at Catawba Bay Condominium

5439 and 5441 Walls Channel Drive
Section 3 Lot 1 Firelands
Catawa Island Twp, Ottawa Co, Ohio