




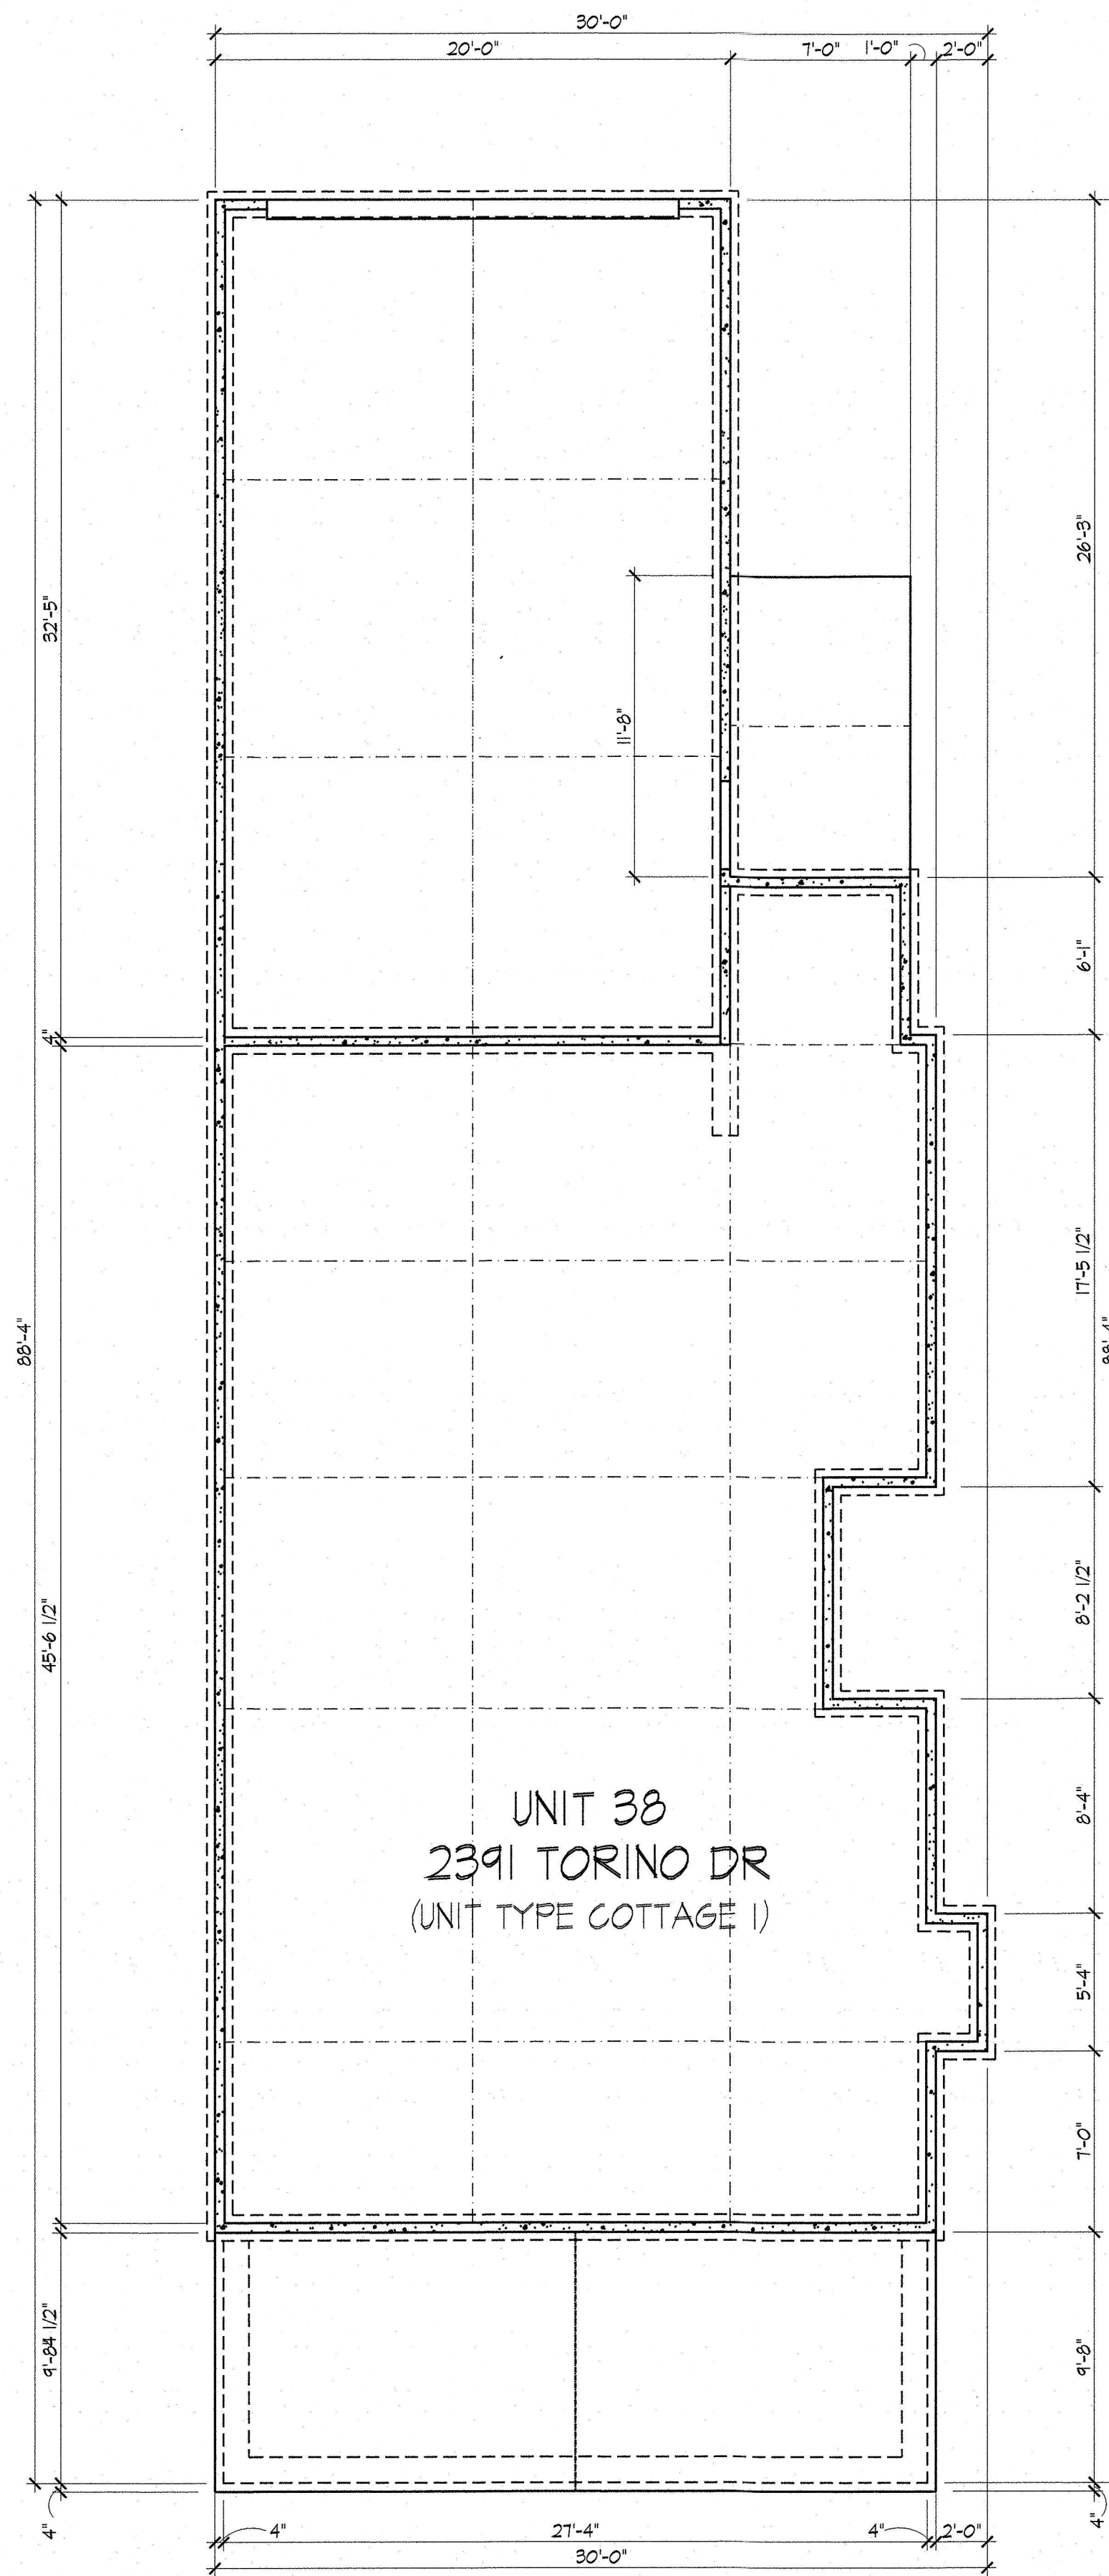

Foundation Plan

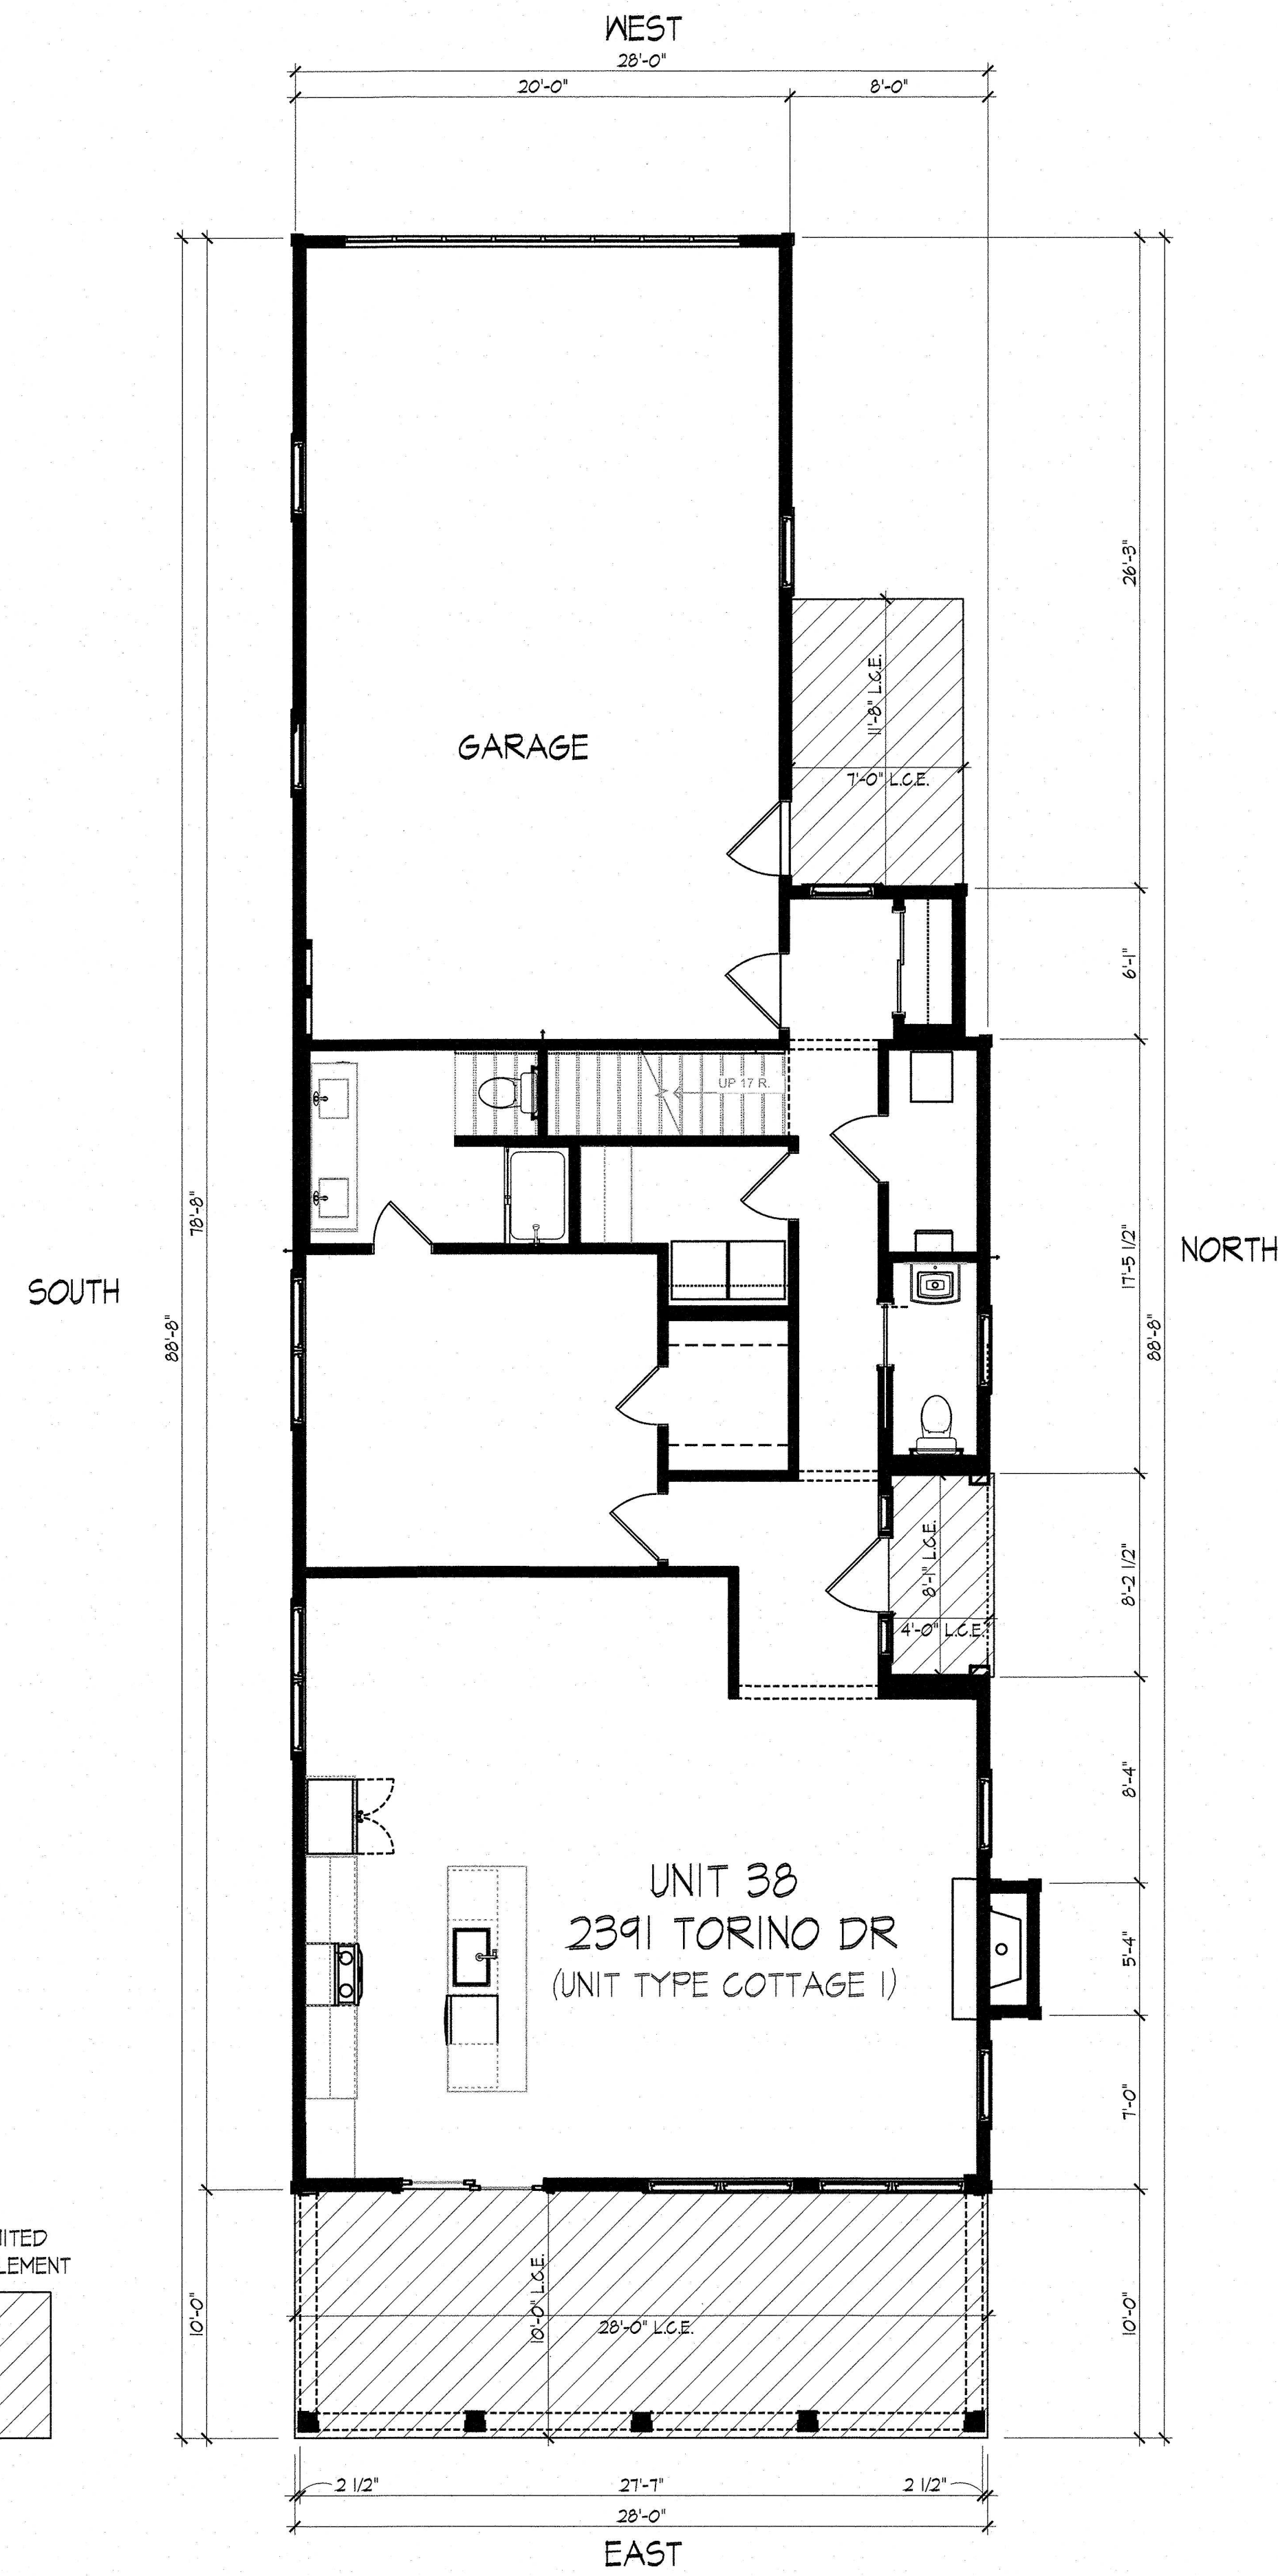

First Floor Plan

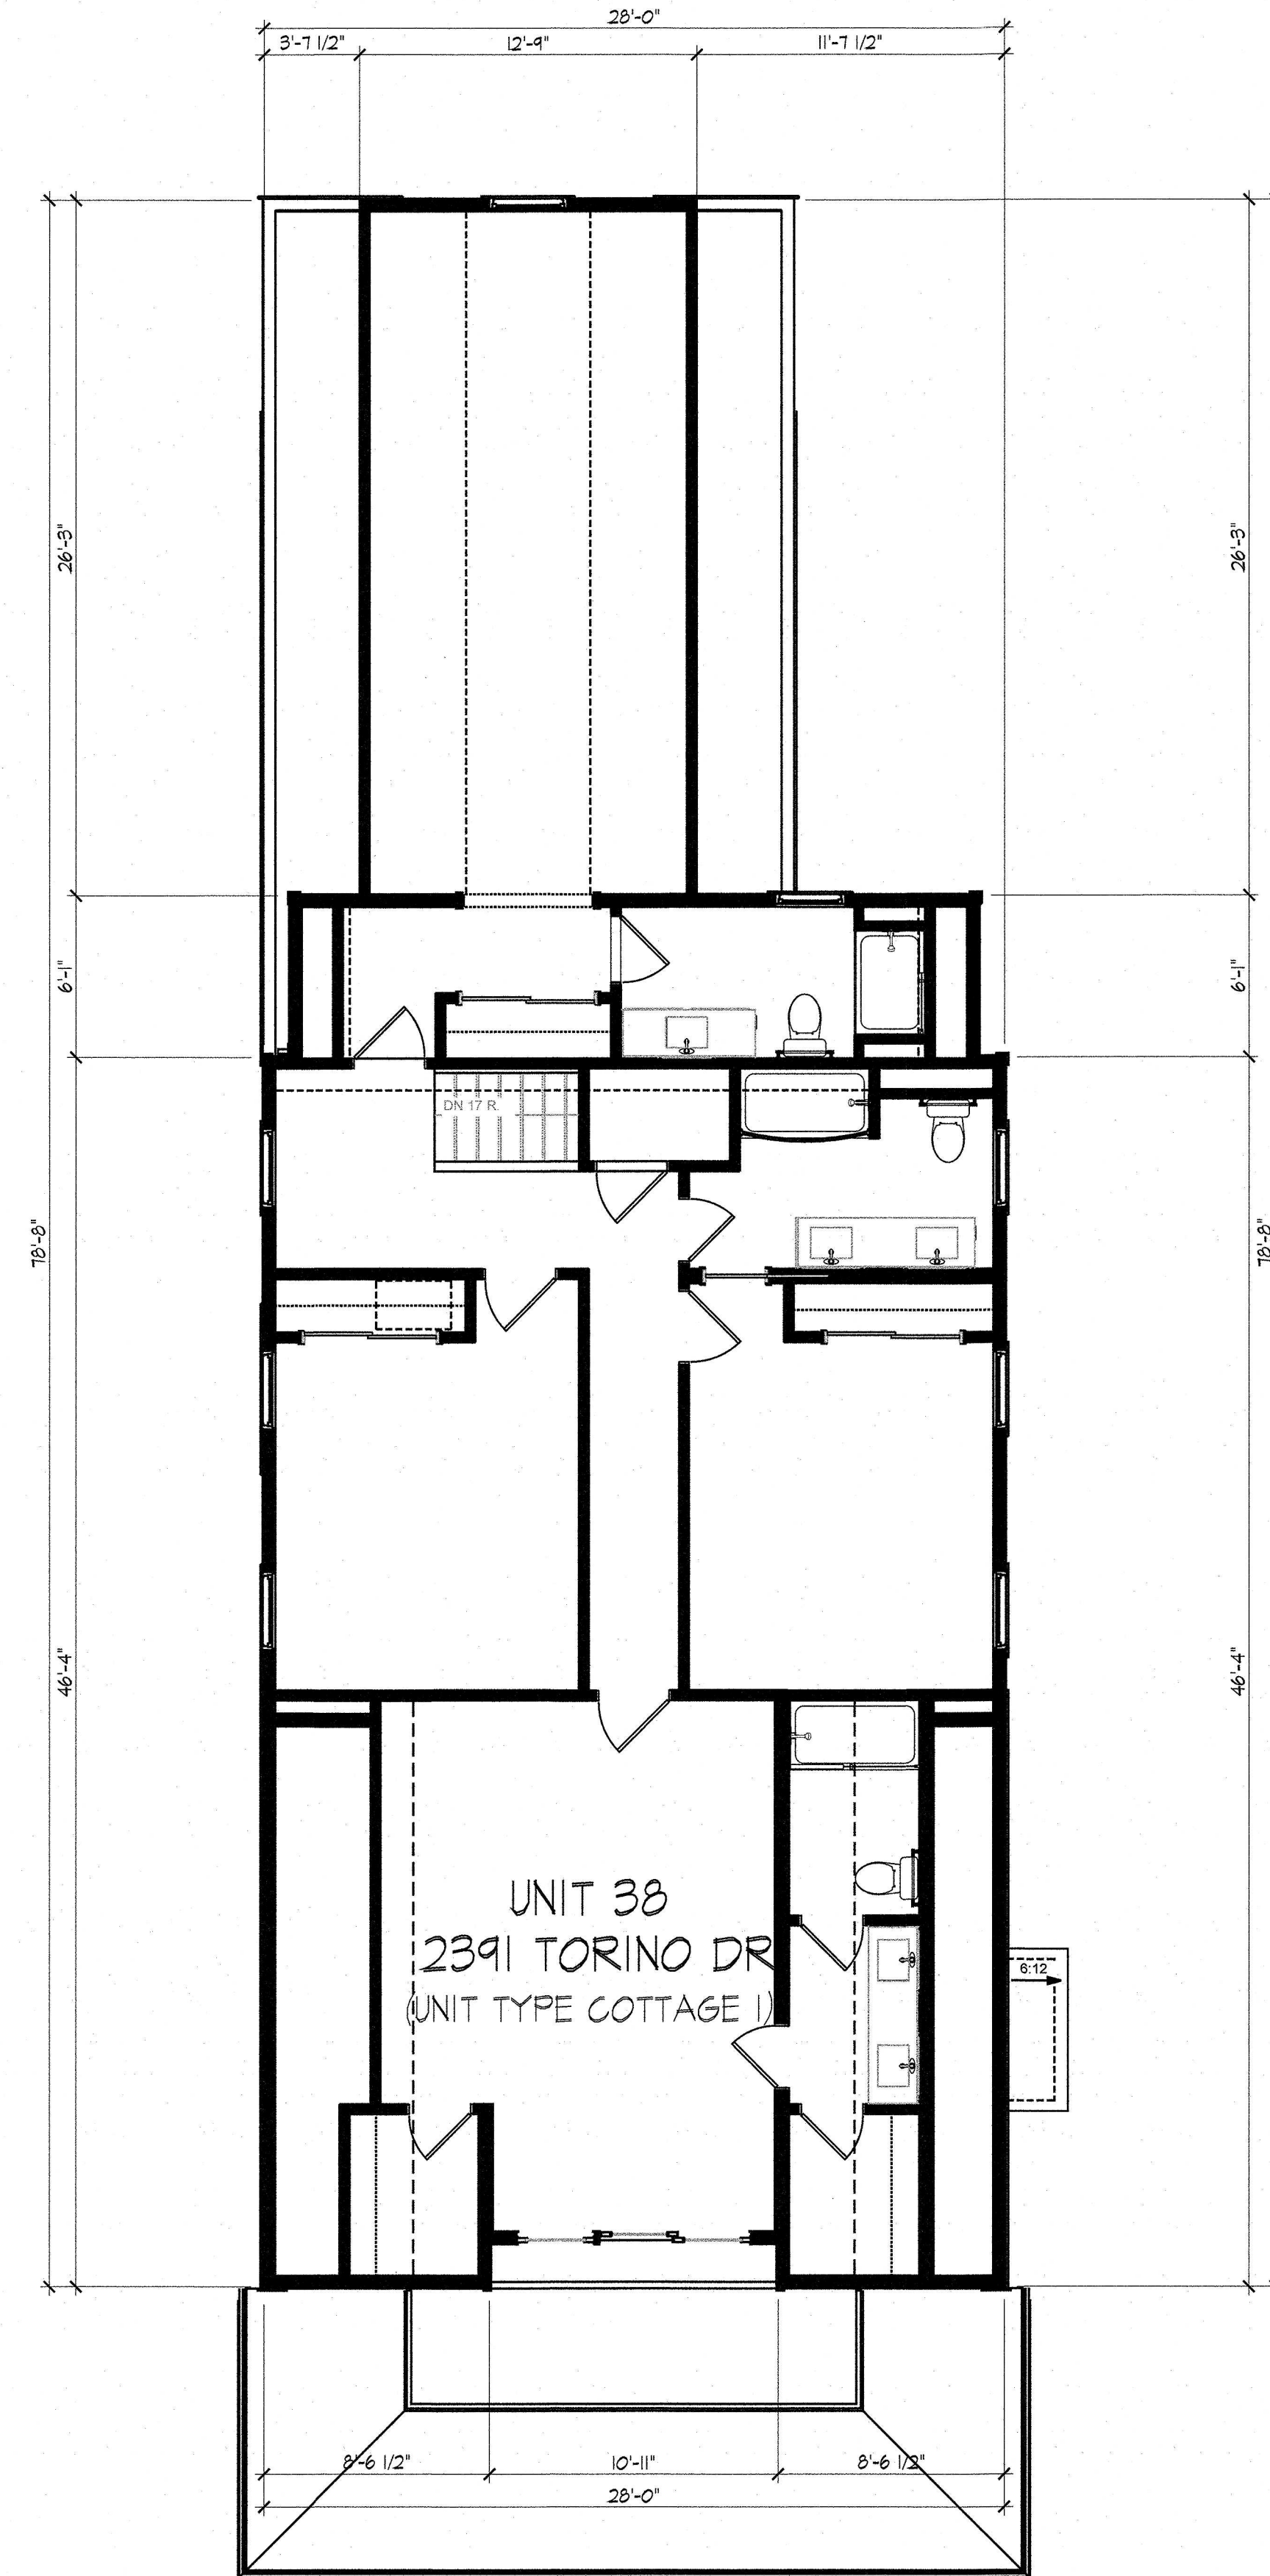

Second Floor Plan

DEAN A. WENZ
ARCHITECTS

323 N ARDMORE ROAD
BEXLEY, OHIO 43209
(614) 239-6868
FAX (614) 239-9868

Fairway Cottages at Catawba Island Club
Unit Owners Association, Inc.
Documentation Drawings
Fifth Amendment

Architect Project Number
2020-046A

Sheet Number

10 of 15



WEST

- Bedroom 5 Cfg. Ht. 17'-5"
- Bedroom 5 Flr 3'-7/8"
- 1st Flr Entry/Garage Cfg. Ht. 8'-1 1/8"
- 1st Flr Window Ht 7'-0"
- First Floor 0'-0"



NORTH

UNIT 38
2391 TORINO DR
(UNIT TYPE COTTAGE 1)

- 2nd Flr Ceiling Ht 19'-9"
- 2nd Flr Window Ht 17'-7 7/8"
- Second Floor 10'-7 7/8"
- 1st Flr Ceiling Ht 9'-1 1/8"
- 1st Flr Window Ht 7'-0"
- First Floor 0'-0"



EAST



SOUTH

Elevations


DEAN A. WENZ
ARCHITECTS

323 N ARDMORE ROAD
BEXLEY, OHIO 43209
(614) 239-6868
FAX (614) 239-9868

Fairway Cottages at Catawba Island Club
Unit Owners Association, Inc.
Documentation Drawings
Fifth Amendment



Architect Project Number
2020-046A

Sheet Number
11 of 15

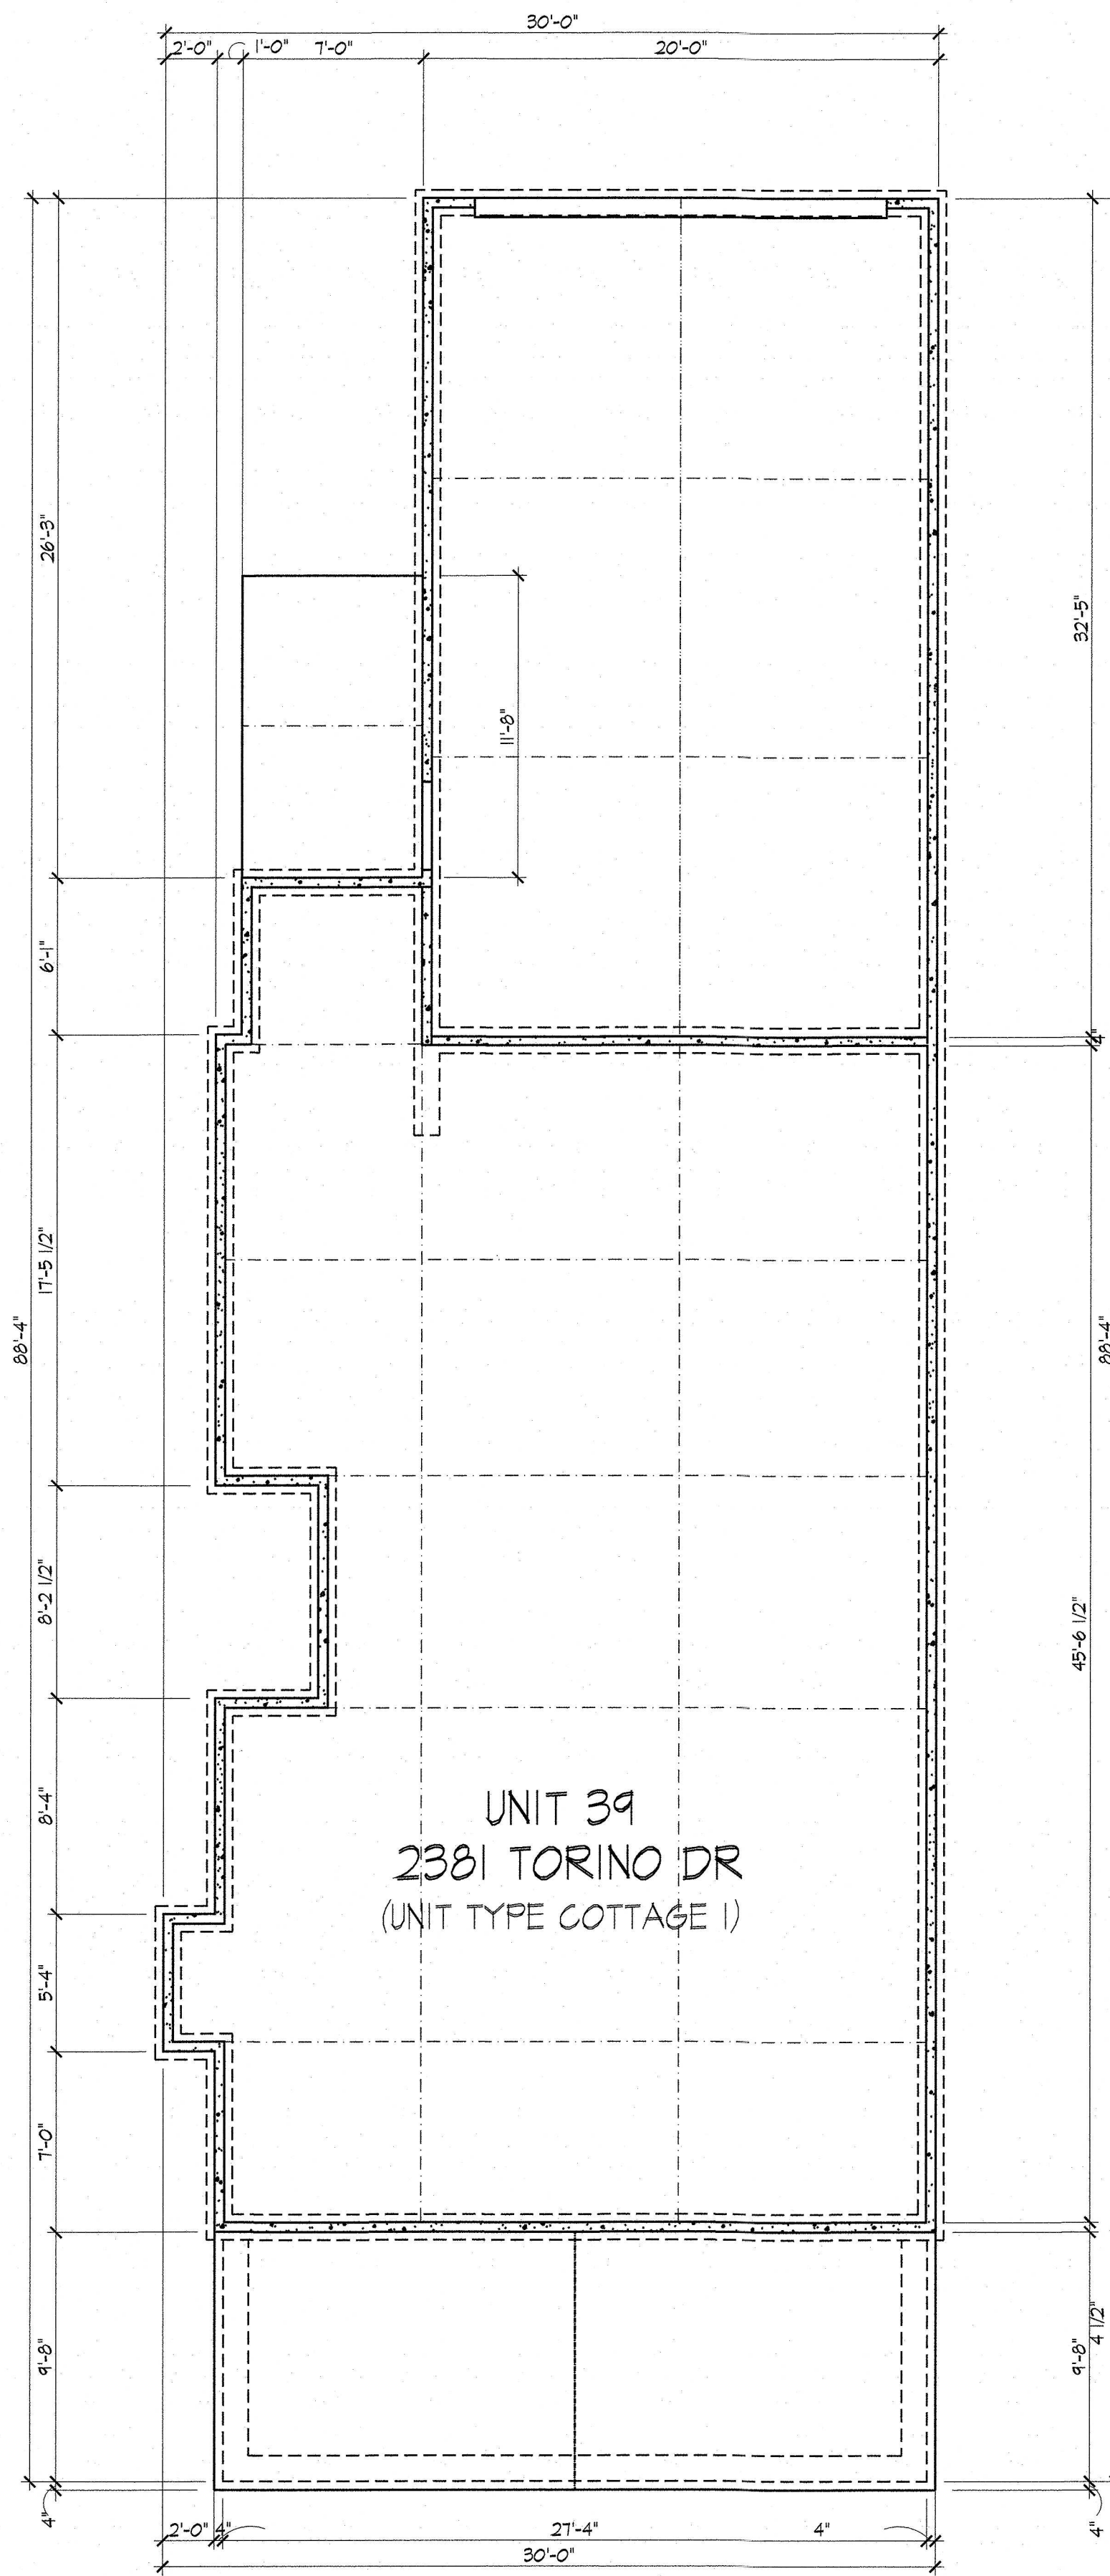


Foundation Plan

L.C.E. = LIMITED
COMMON ELEMENT

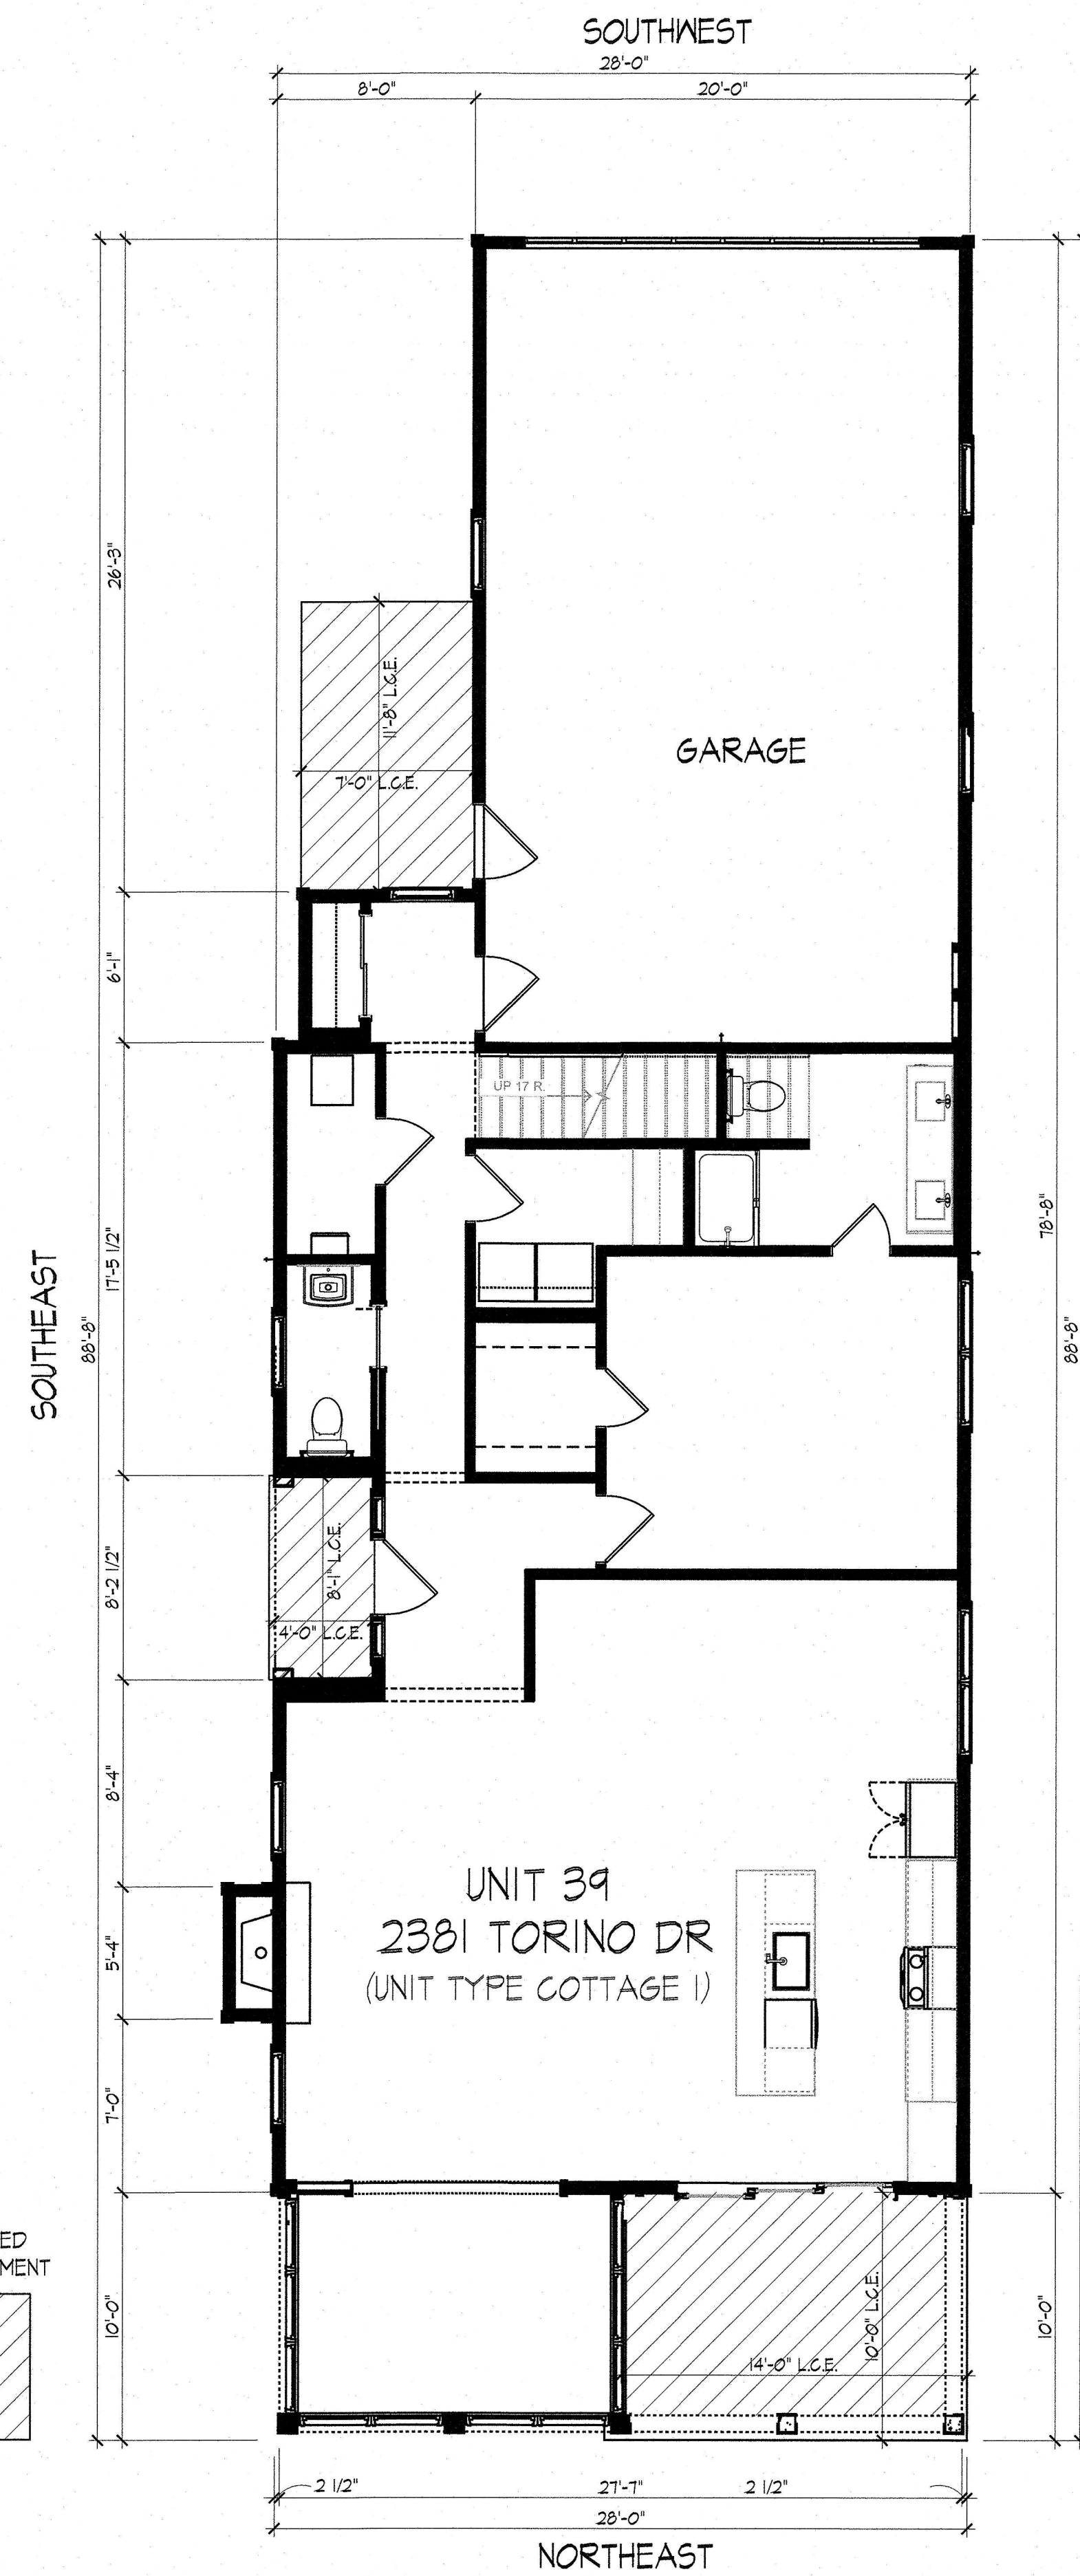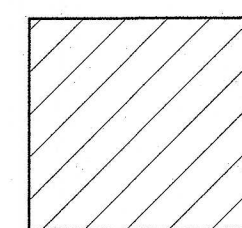

First Floor Plan

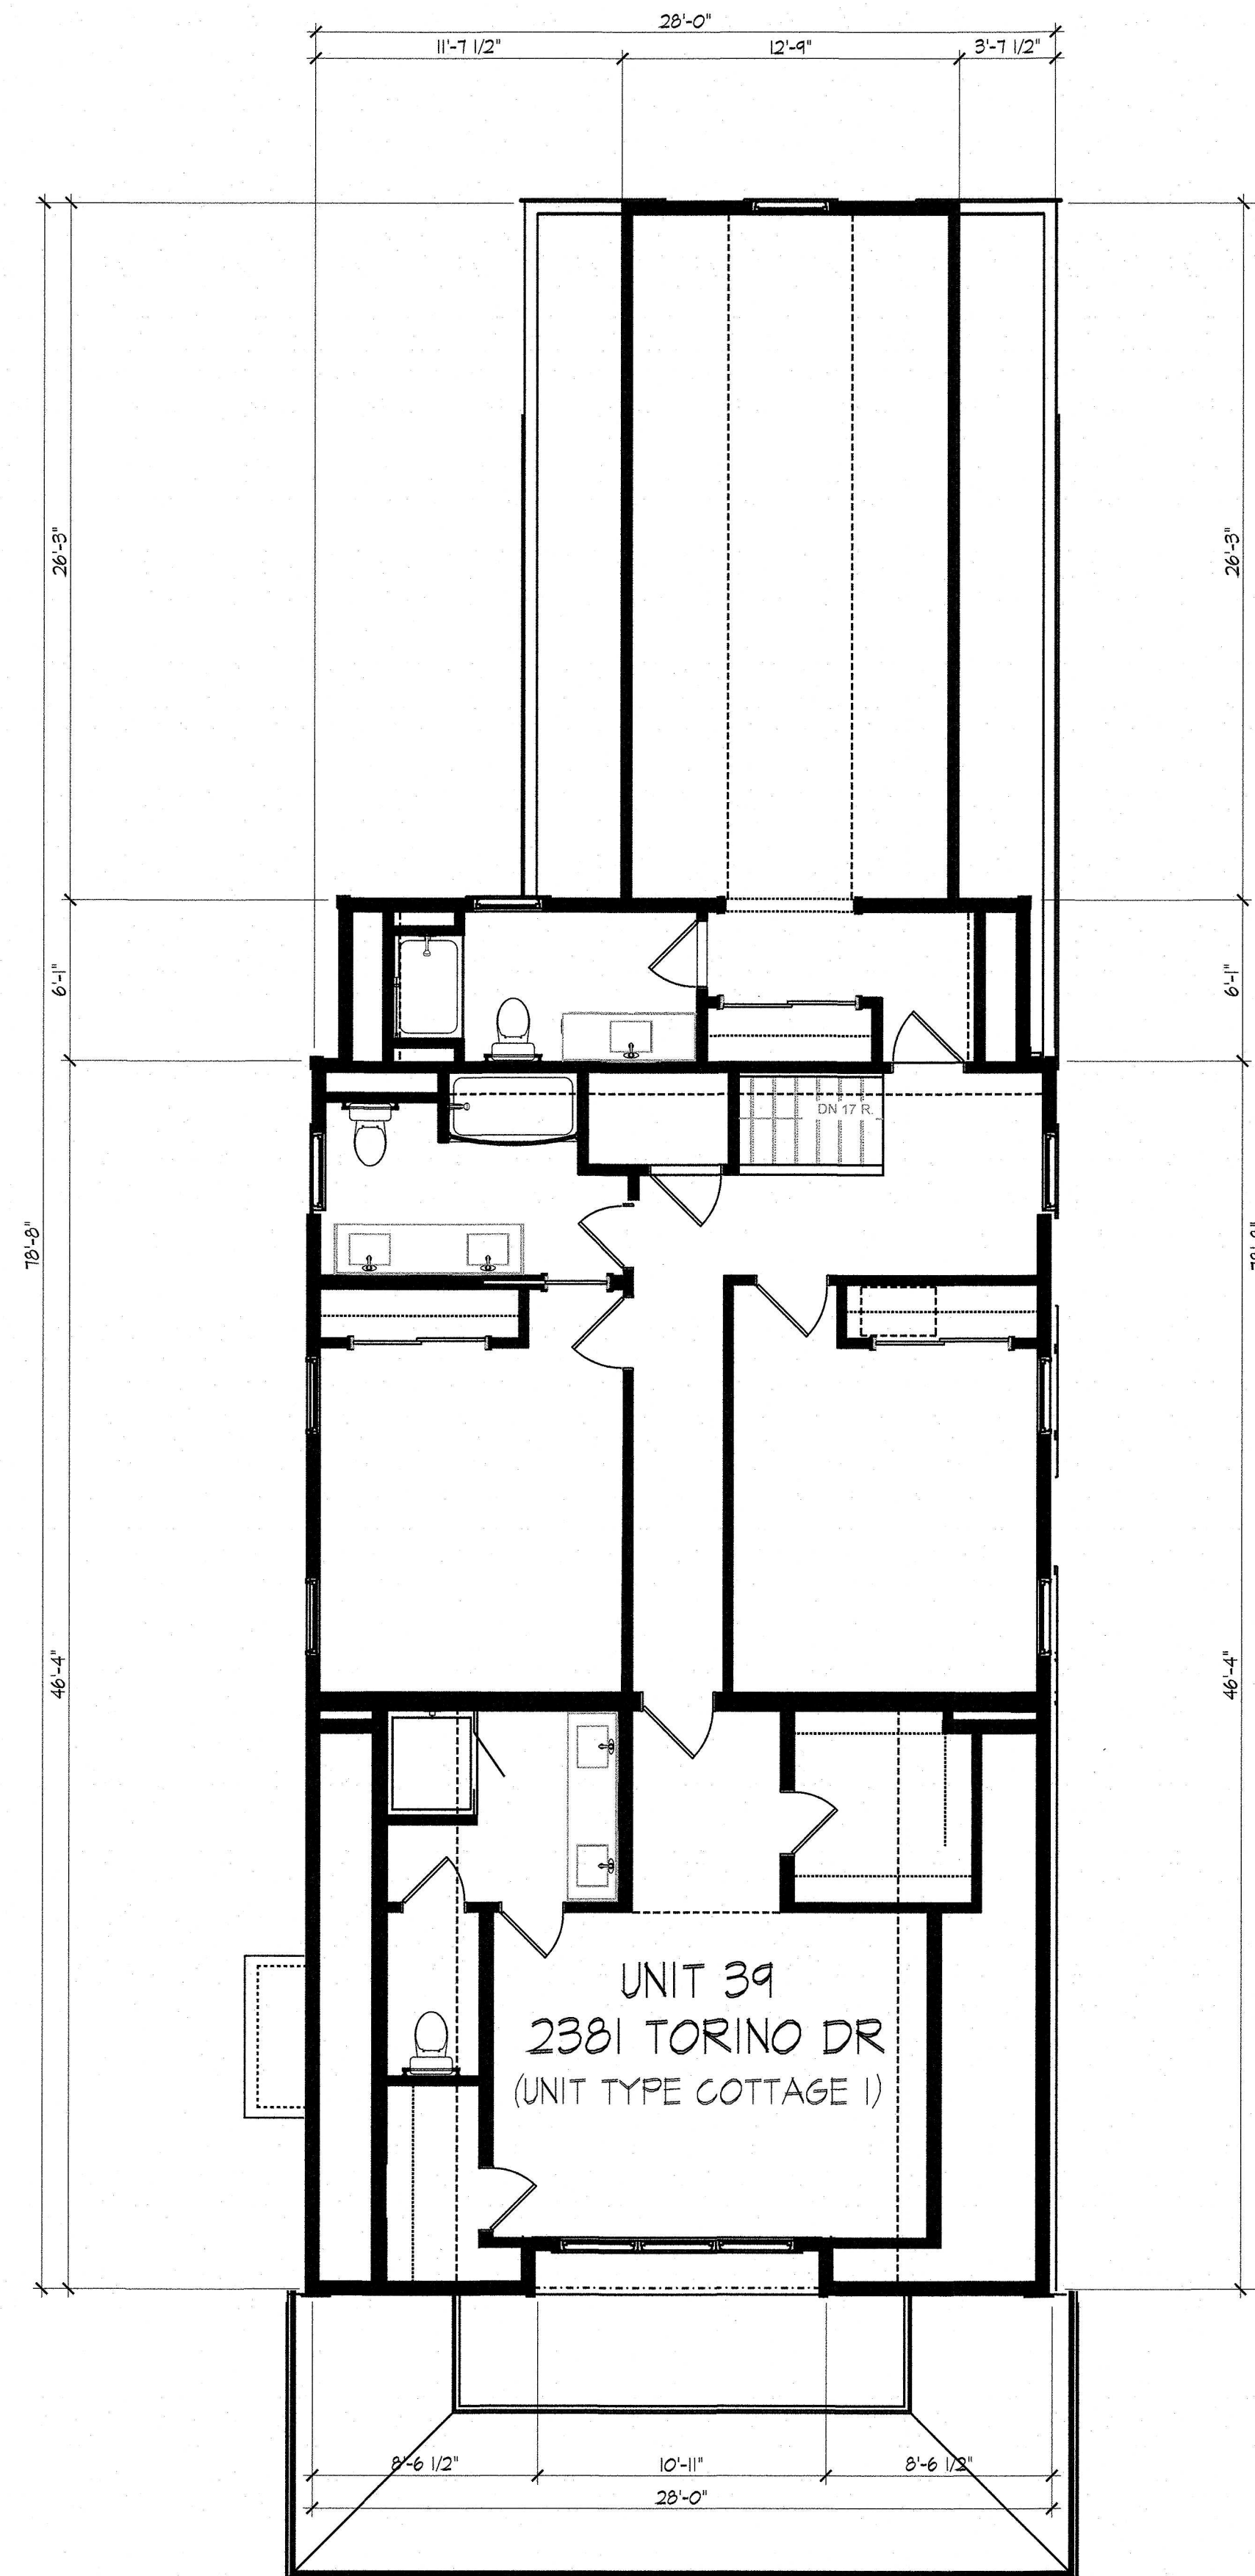

Second Floor Plan

DEAN A. WENZ
ARCHITECTS

323 N ARDMORE ROAD
BEXLEY, OHIO 43209
(614) 239-6868
FAX (614) 239-9868

Fairway Cottages at Catawba Island Club
Unit Owners Association, Inc.
Documentation Drawings
Fifth Amendment

Architect Project Number
2020-046A

Sheet Number
12 of 15



SOUTHWEST



SOUTHEAST

UNIT 39
2381 TORINO DR
(UNIT TYPE COTTAGE I)



NORTHEAST



NORTHWEST

Elevations


DEAN A. WENZ
ARCHITECTS

323 N ARDMORE ROAD
BEXLEY, OHIO 43209
(614) 239-6868
FAX (614) 239-9868


Fairway Cottages at Catawba Island Club
Unit Owners Association, Inc.
Documentation Drawings
Fifth Amendment

Architect Project Number
2020-046A


Sheet Number
13 of 15

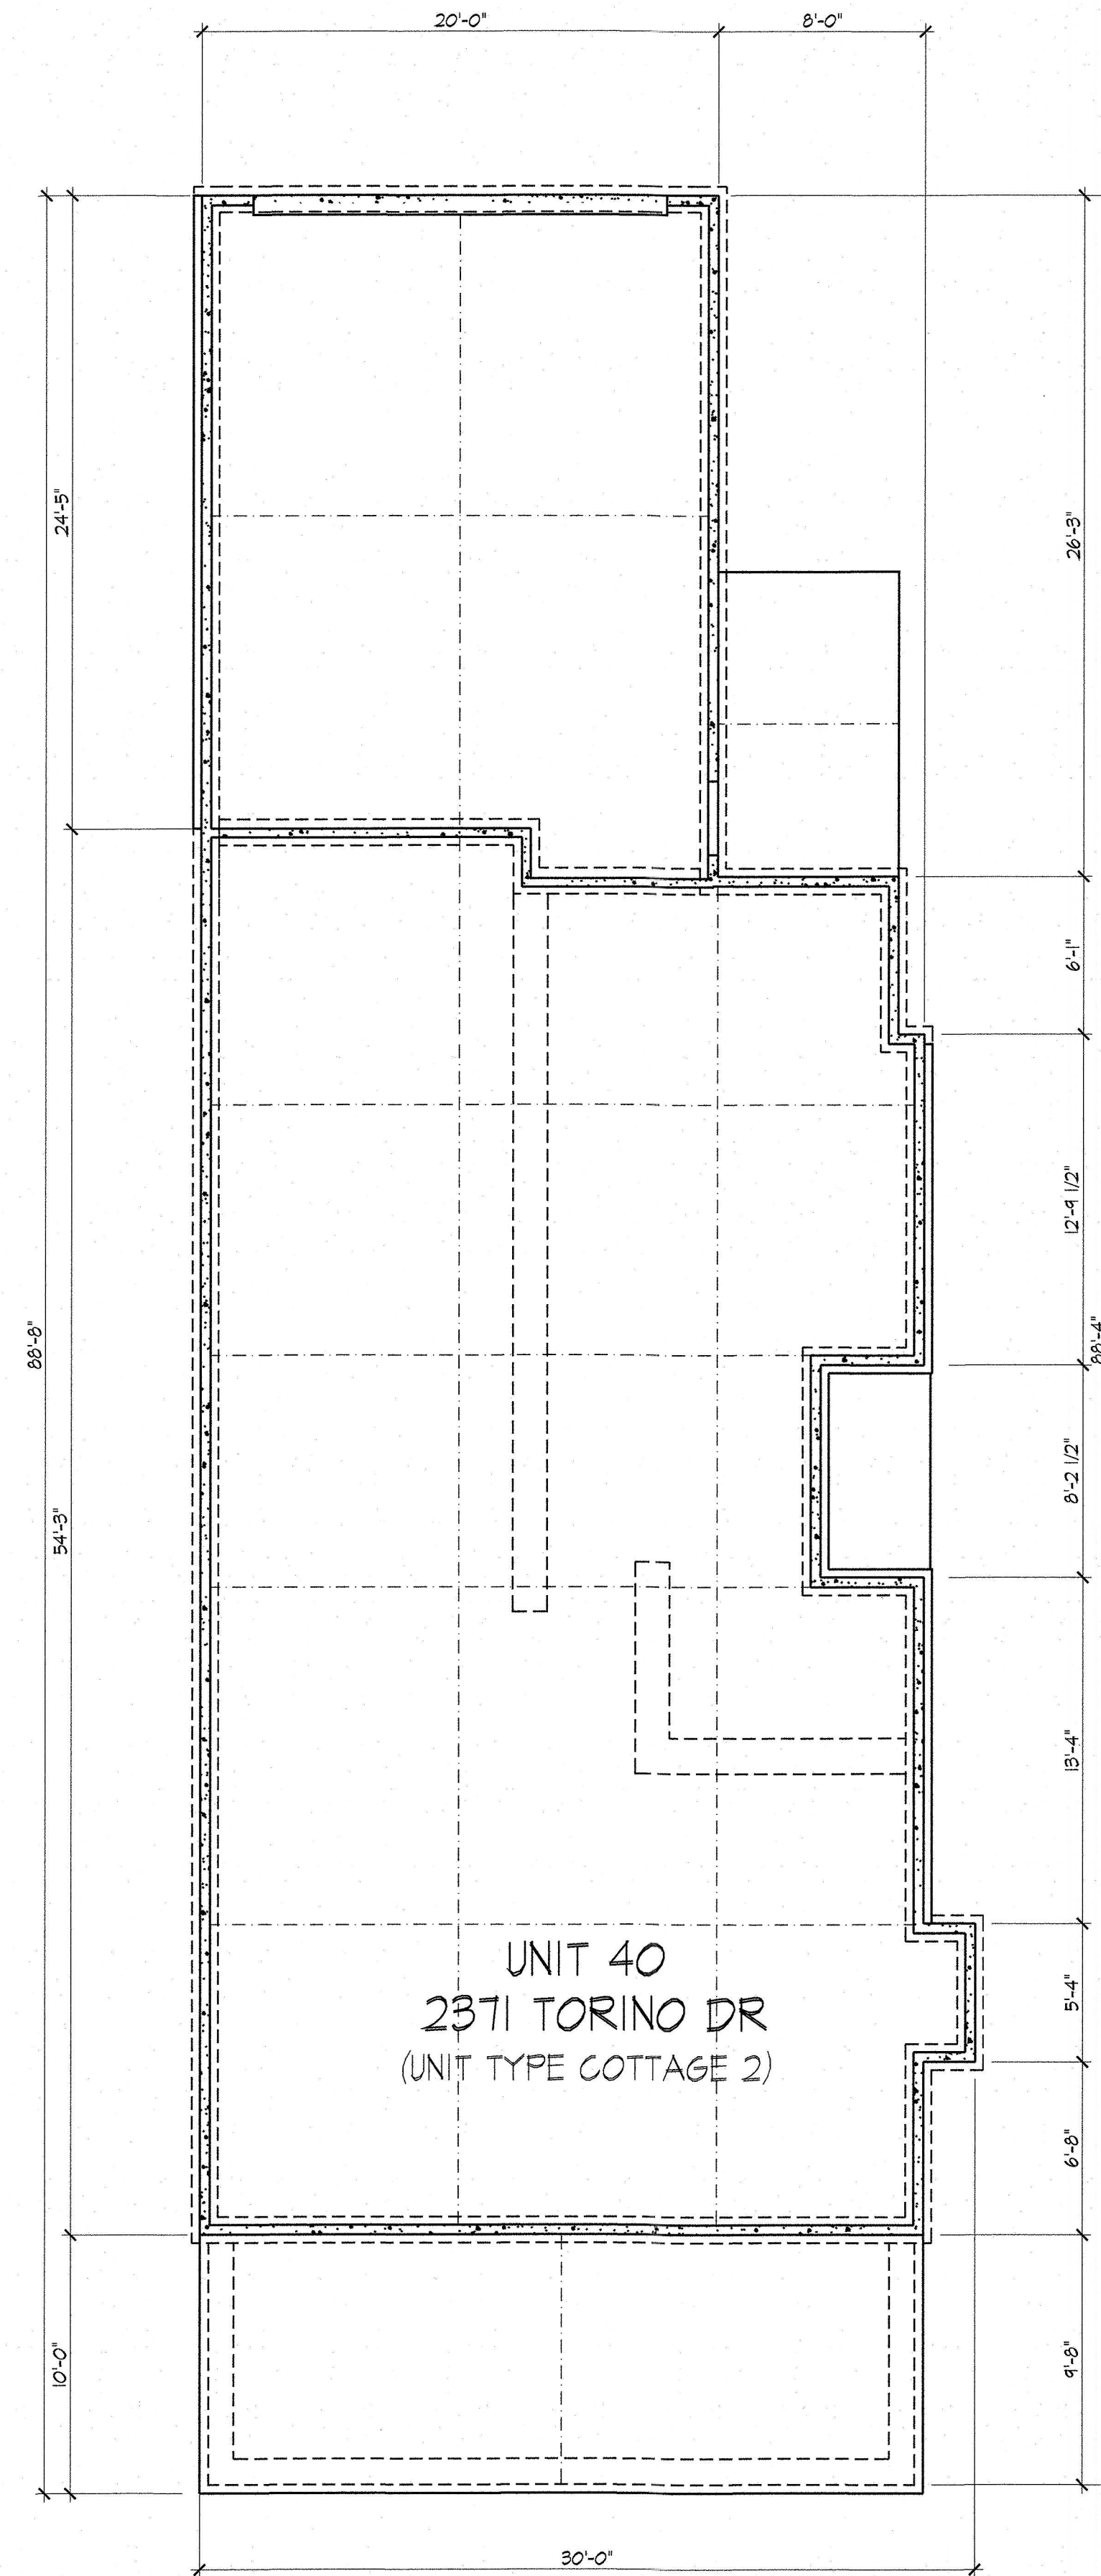

Foundation Plan

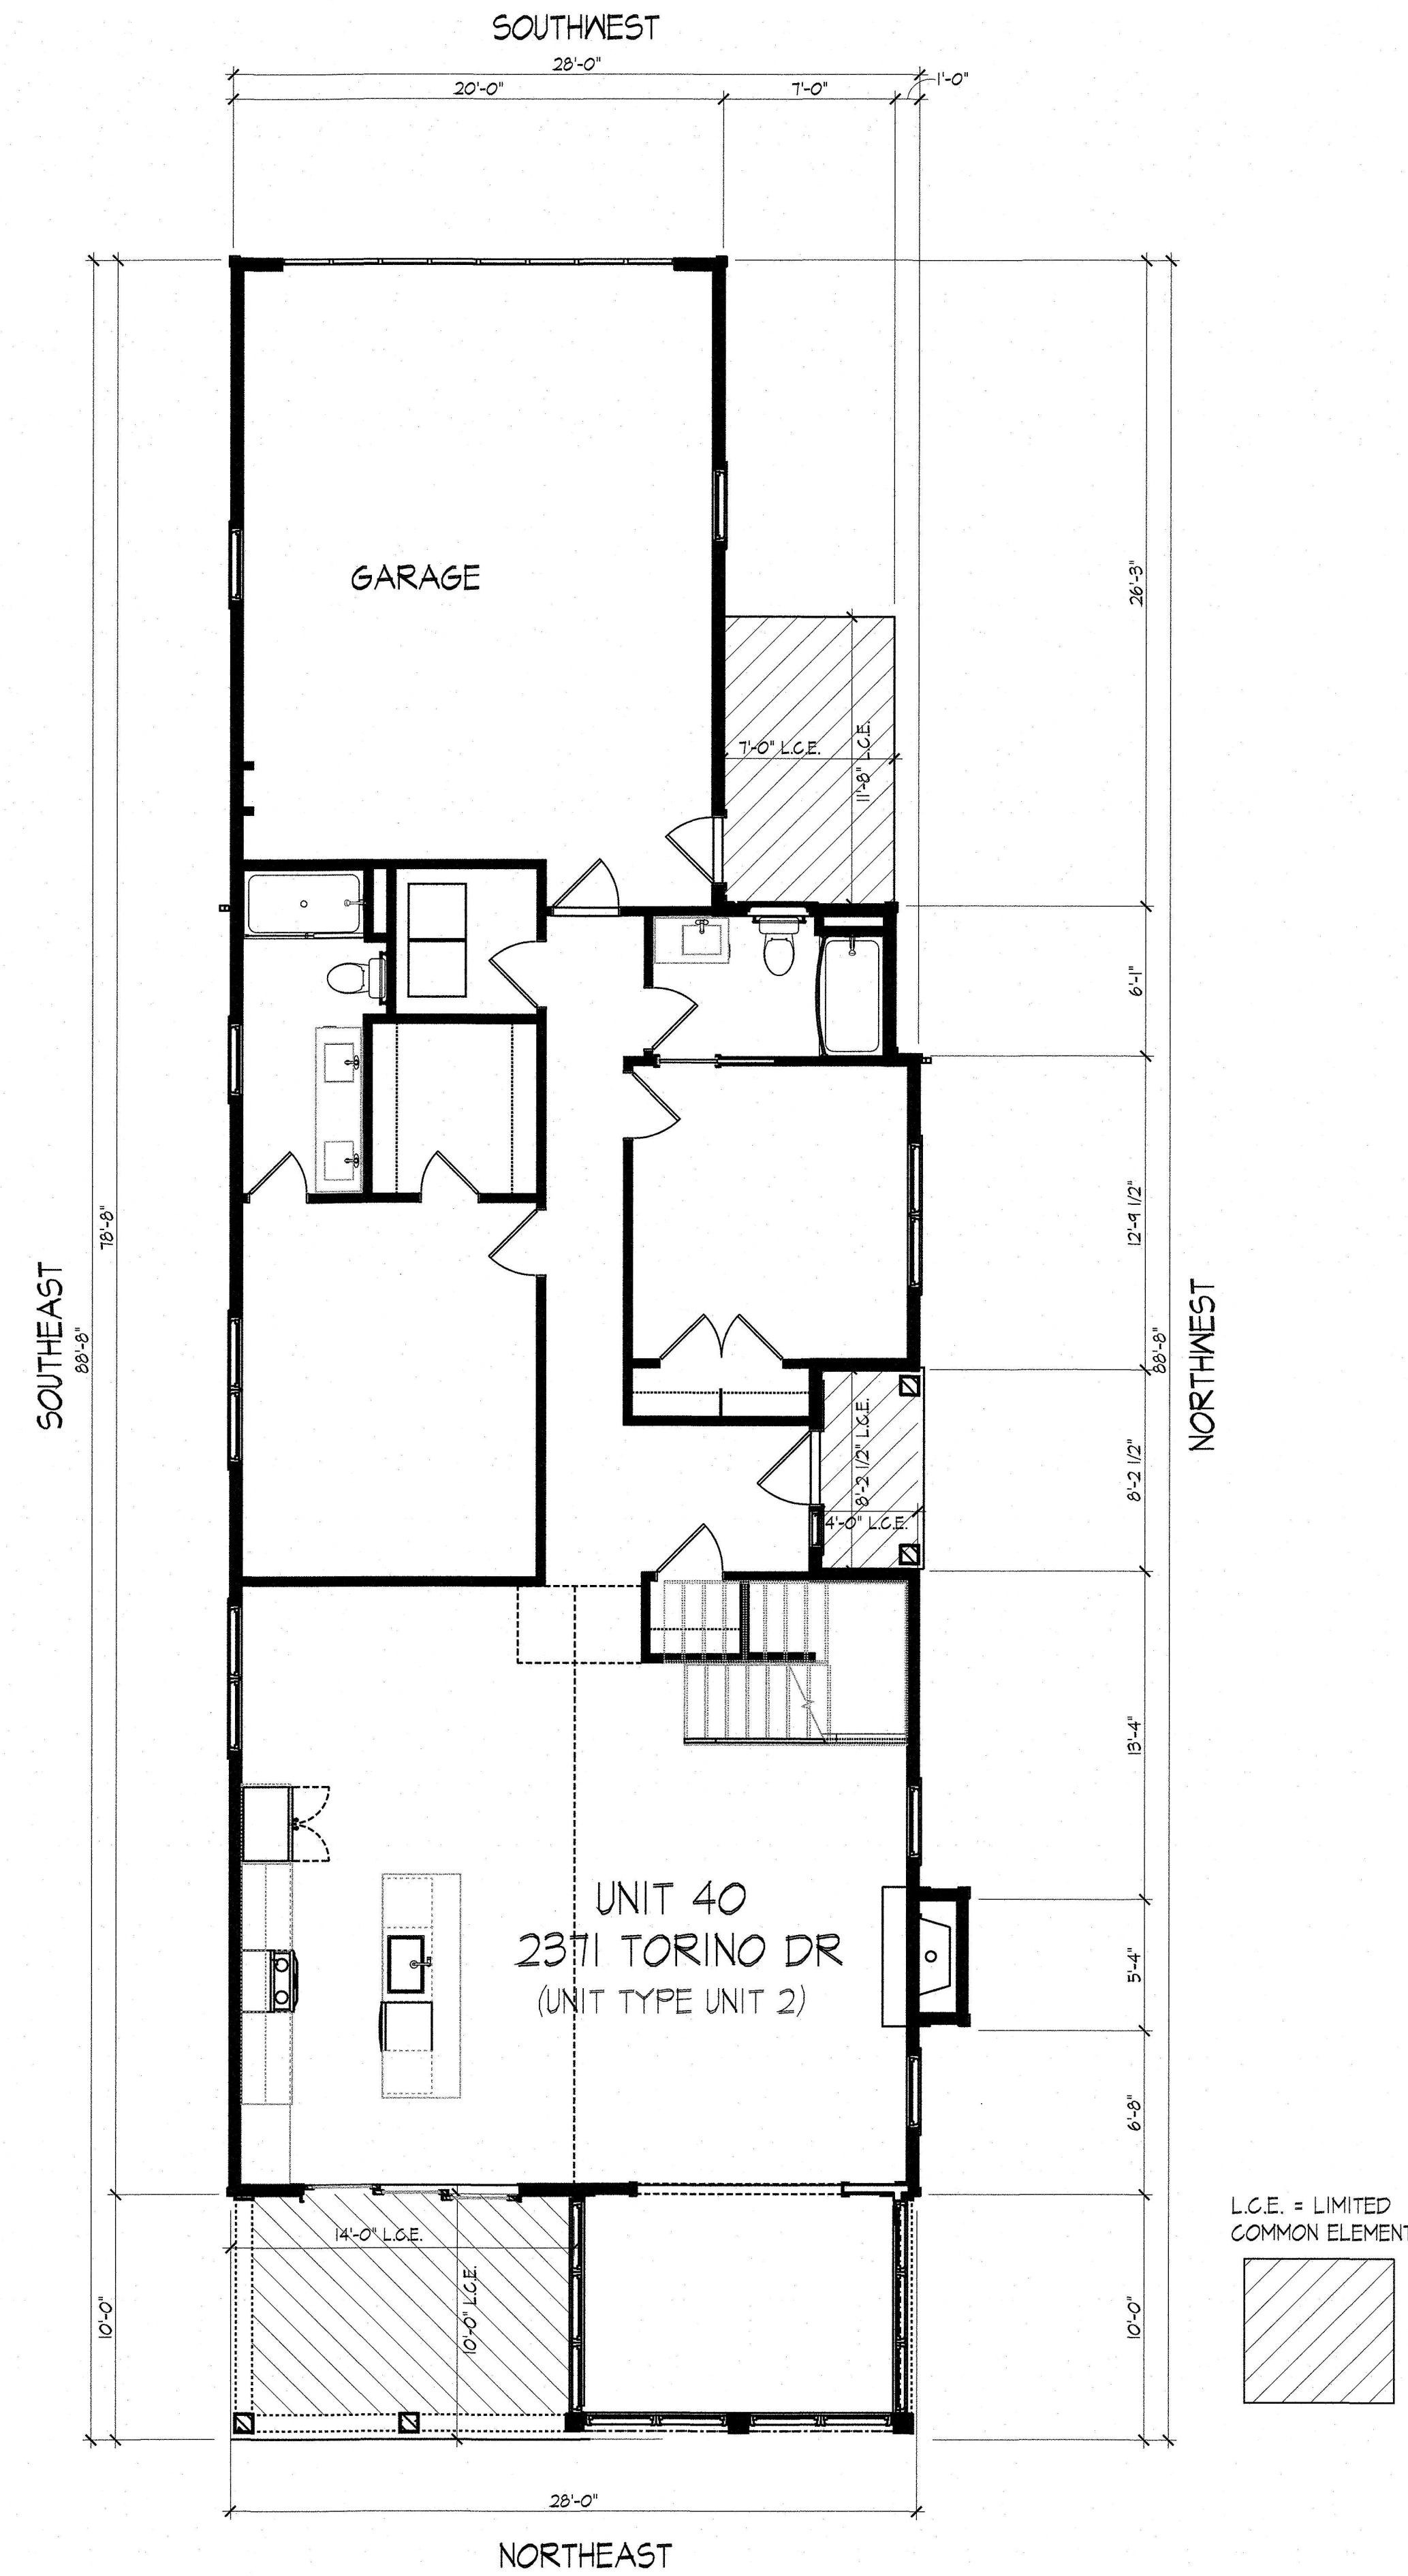

First Floor Plan

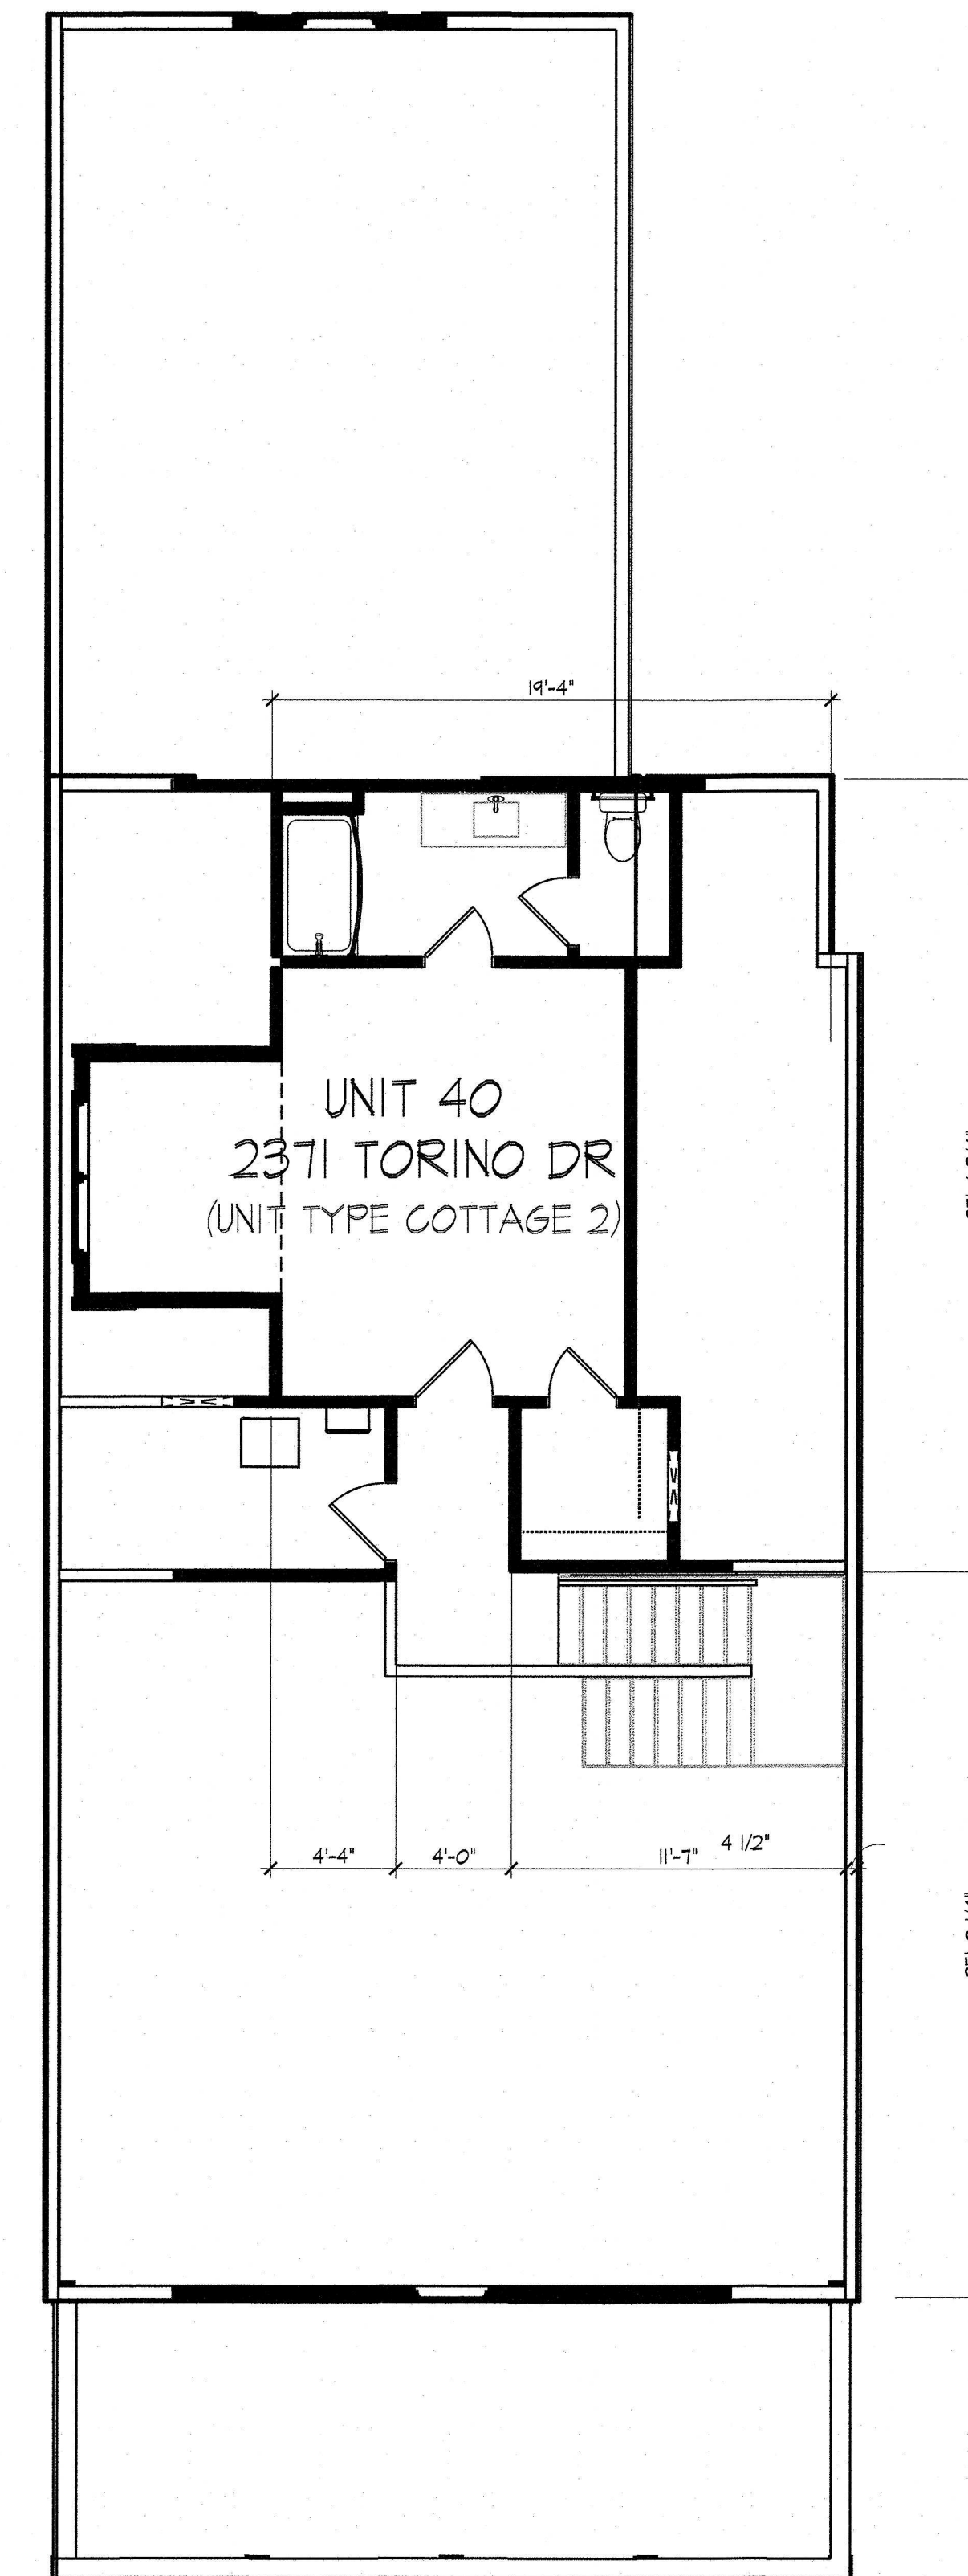

Second Floor Plan

DEAN A. WENZ
ARCHITECTS

323 N ARDMORE ROAD
BEXLEY, OHIO 43209
(614) 239-6868
FAX (614) 239-9868

Fairway Cottages at Catawba Island Club
Unit Owners Association, Inc.
Documentation Drawings
Fifth Amendment


Architect Project Number
2020-046A

Sheet Number


14 of 15




NORTHEAST

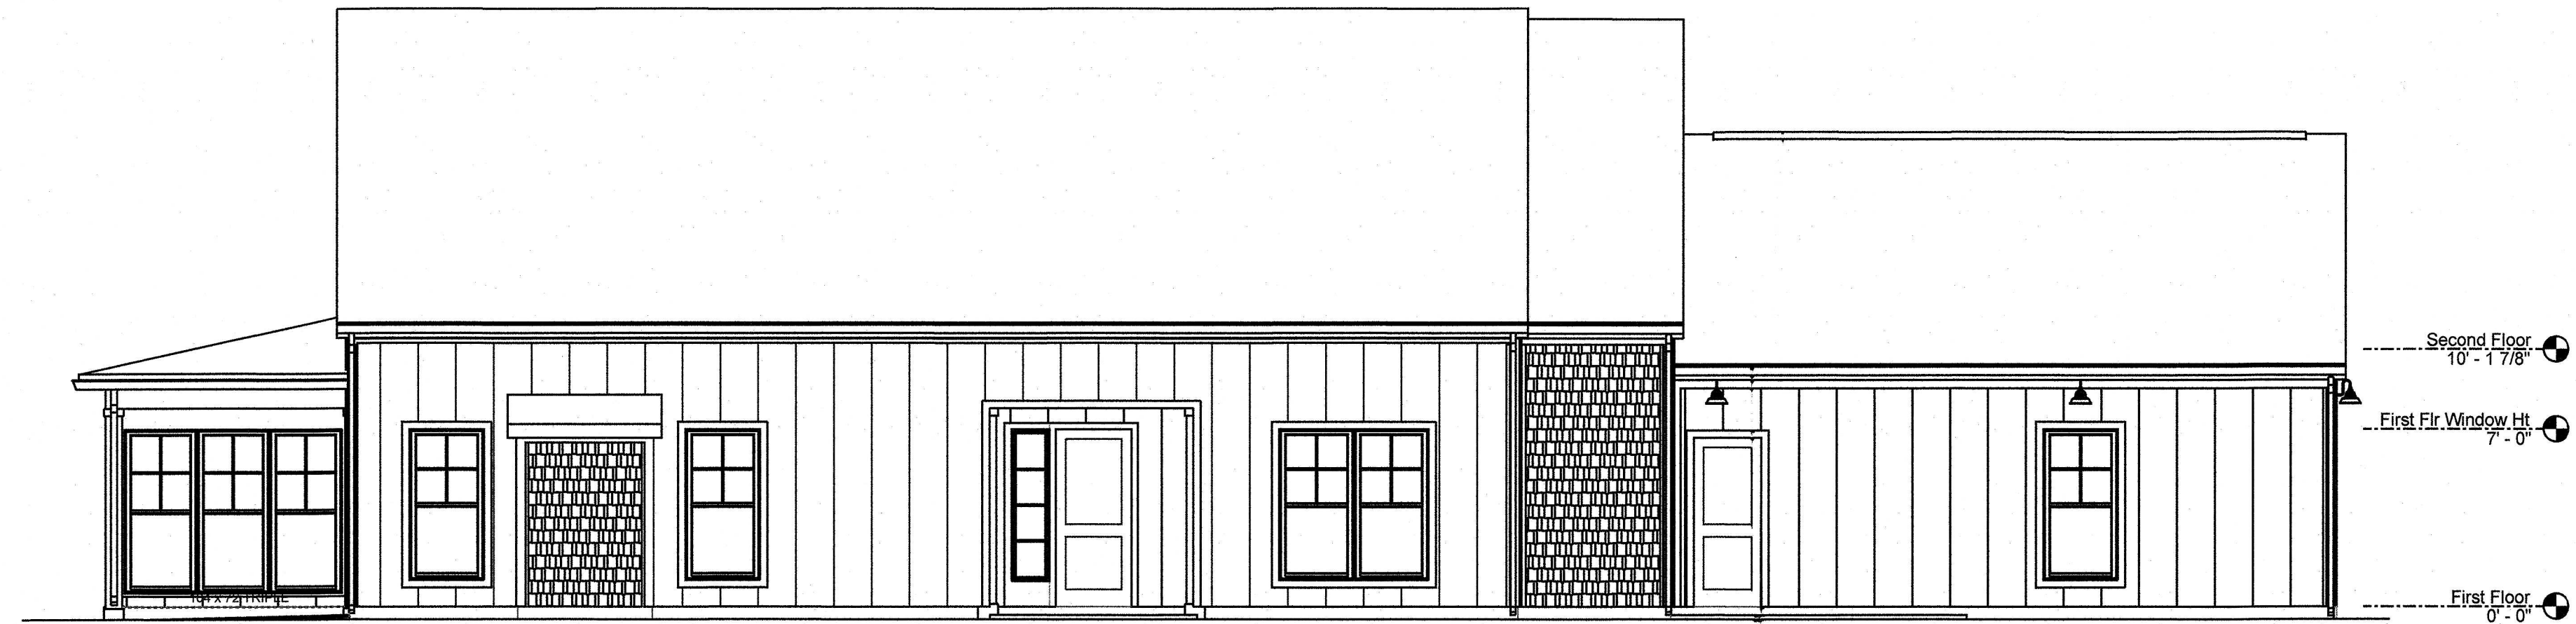

NORTHWEST UNIT 40
2371 TORINO DR
(UNIT TYPE COTTAGE 2)

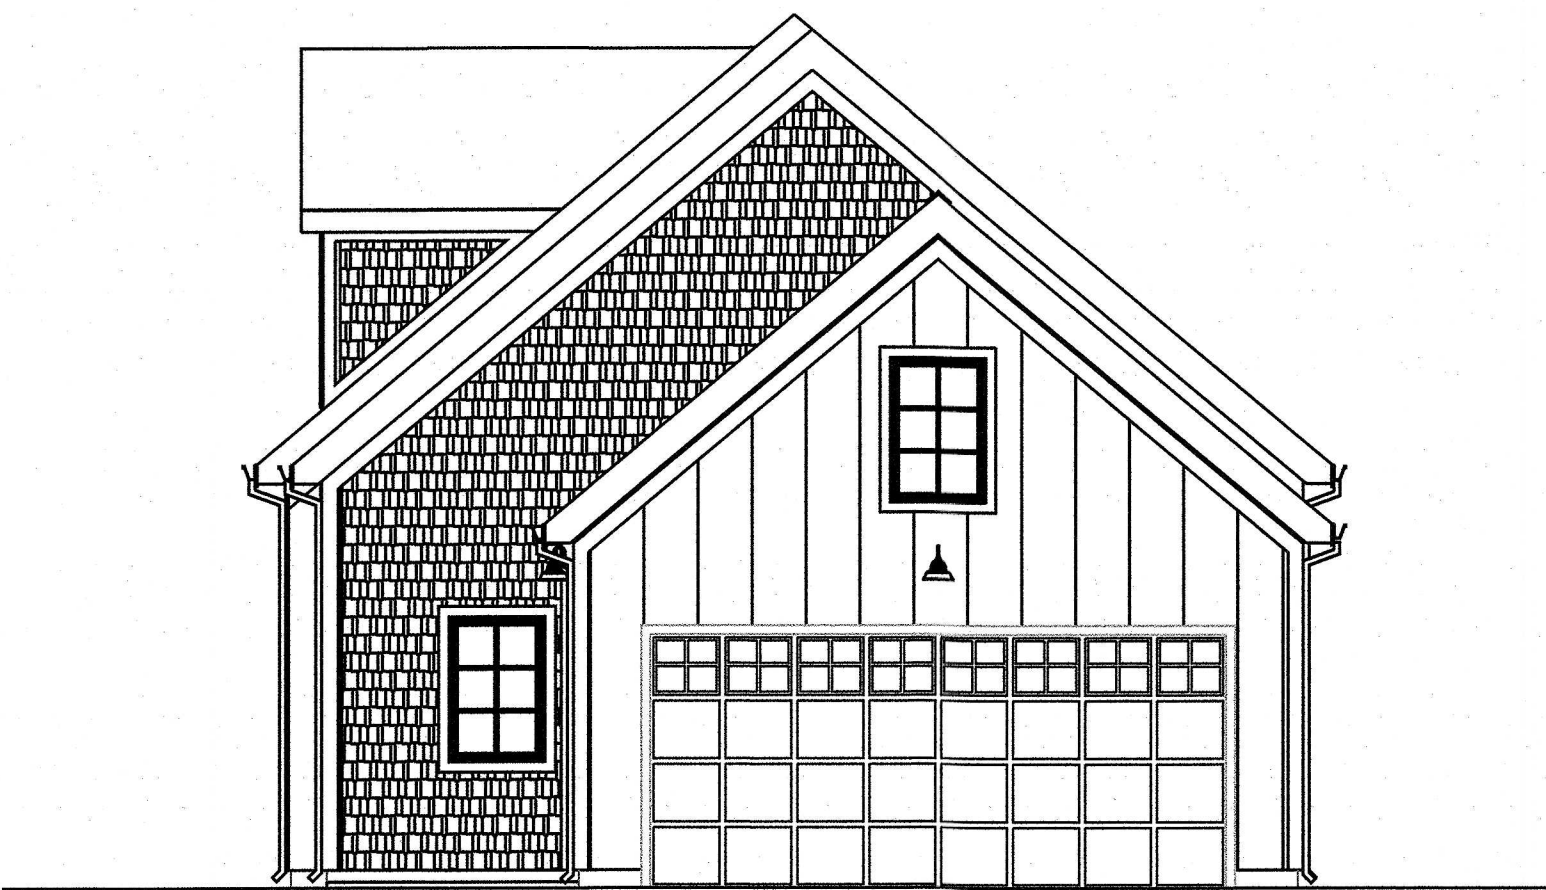

SOUTHWEST

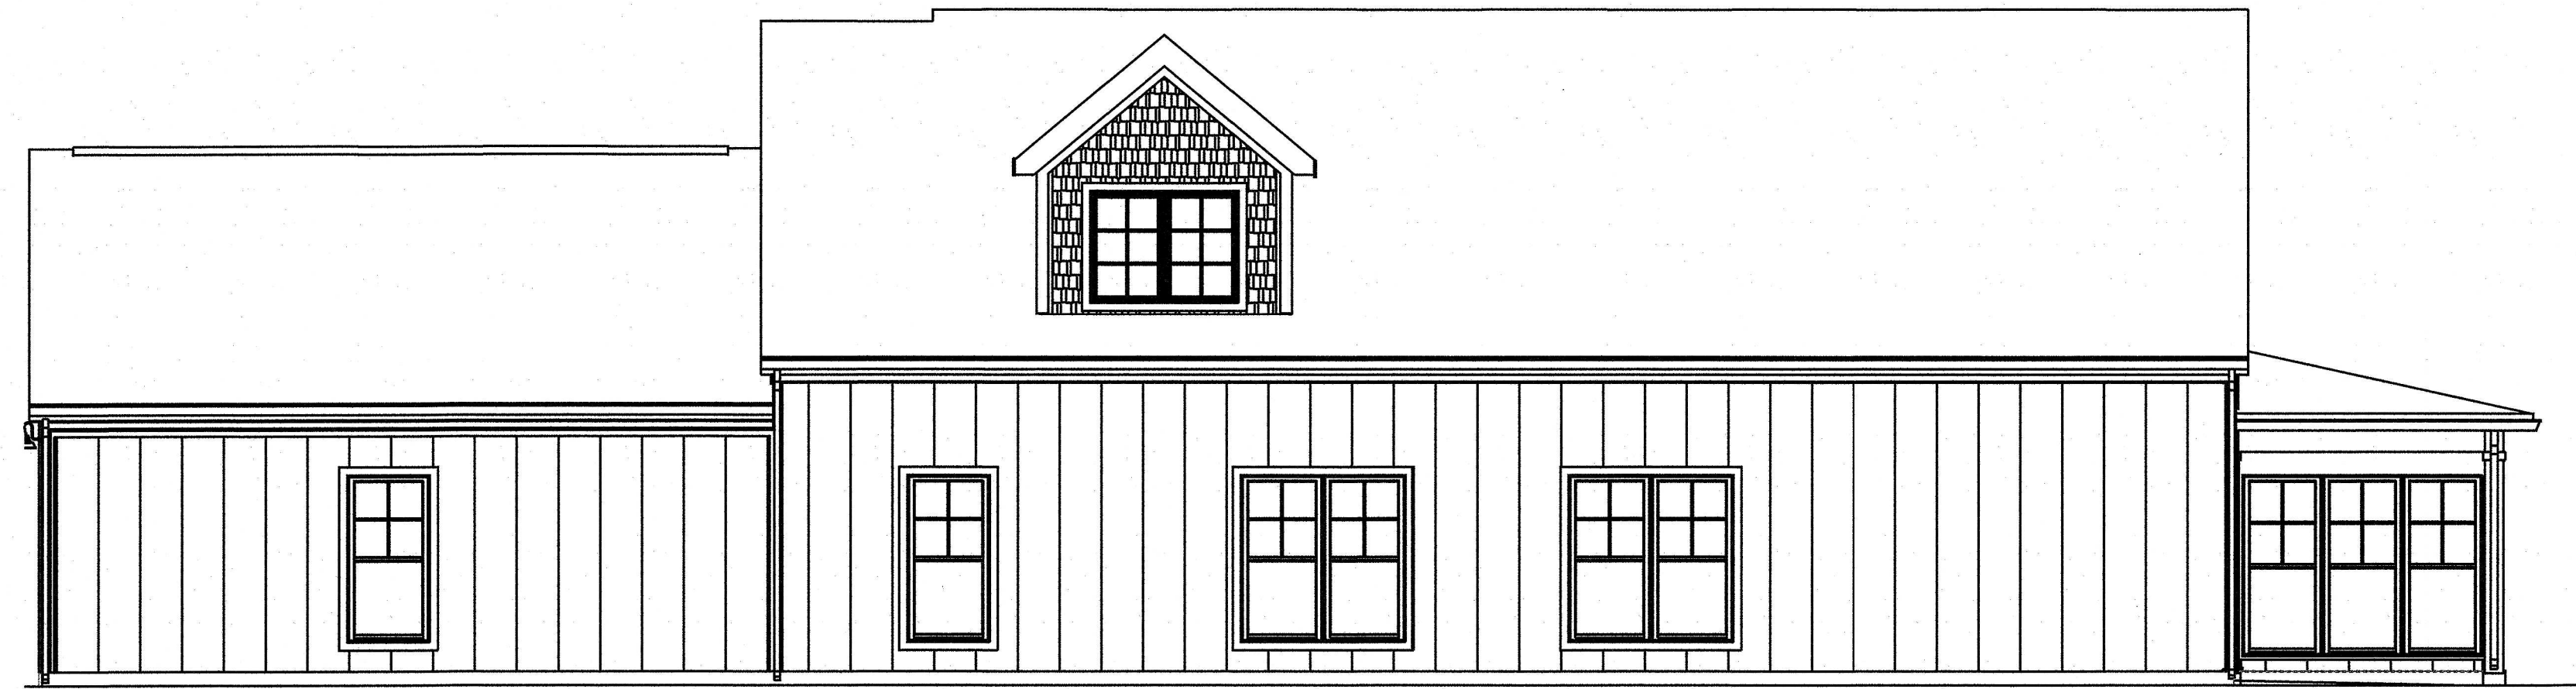

SOUTHEAST

Elevations

DEAN A. WENZ
ARCHITECTS

323 N ARDMORE ROAD
BEXLEY, OHIO 43209
(614) 239-6868
FAX (614) 239-9868

Fairway Cottages at Catawba Island Club
Unit Owners Association, Inc.
Documentation Drawings
Fifth Amendment

Architect Project Number
2020-046A

Sheet Number

15 of 15