







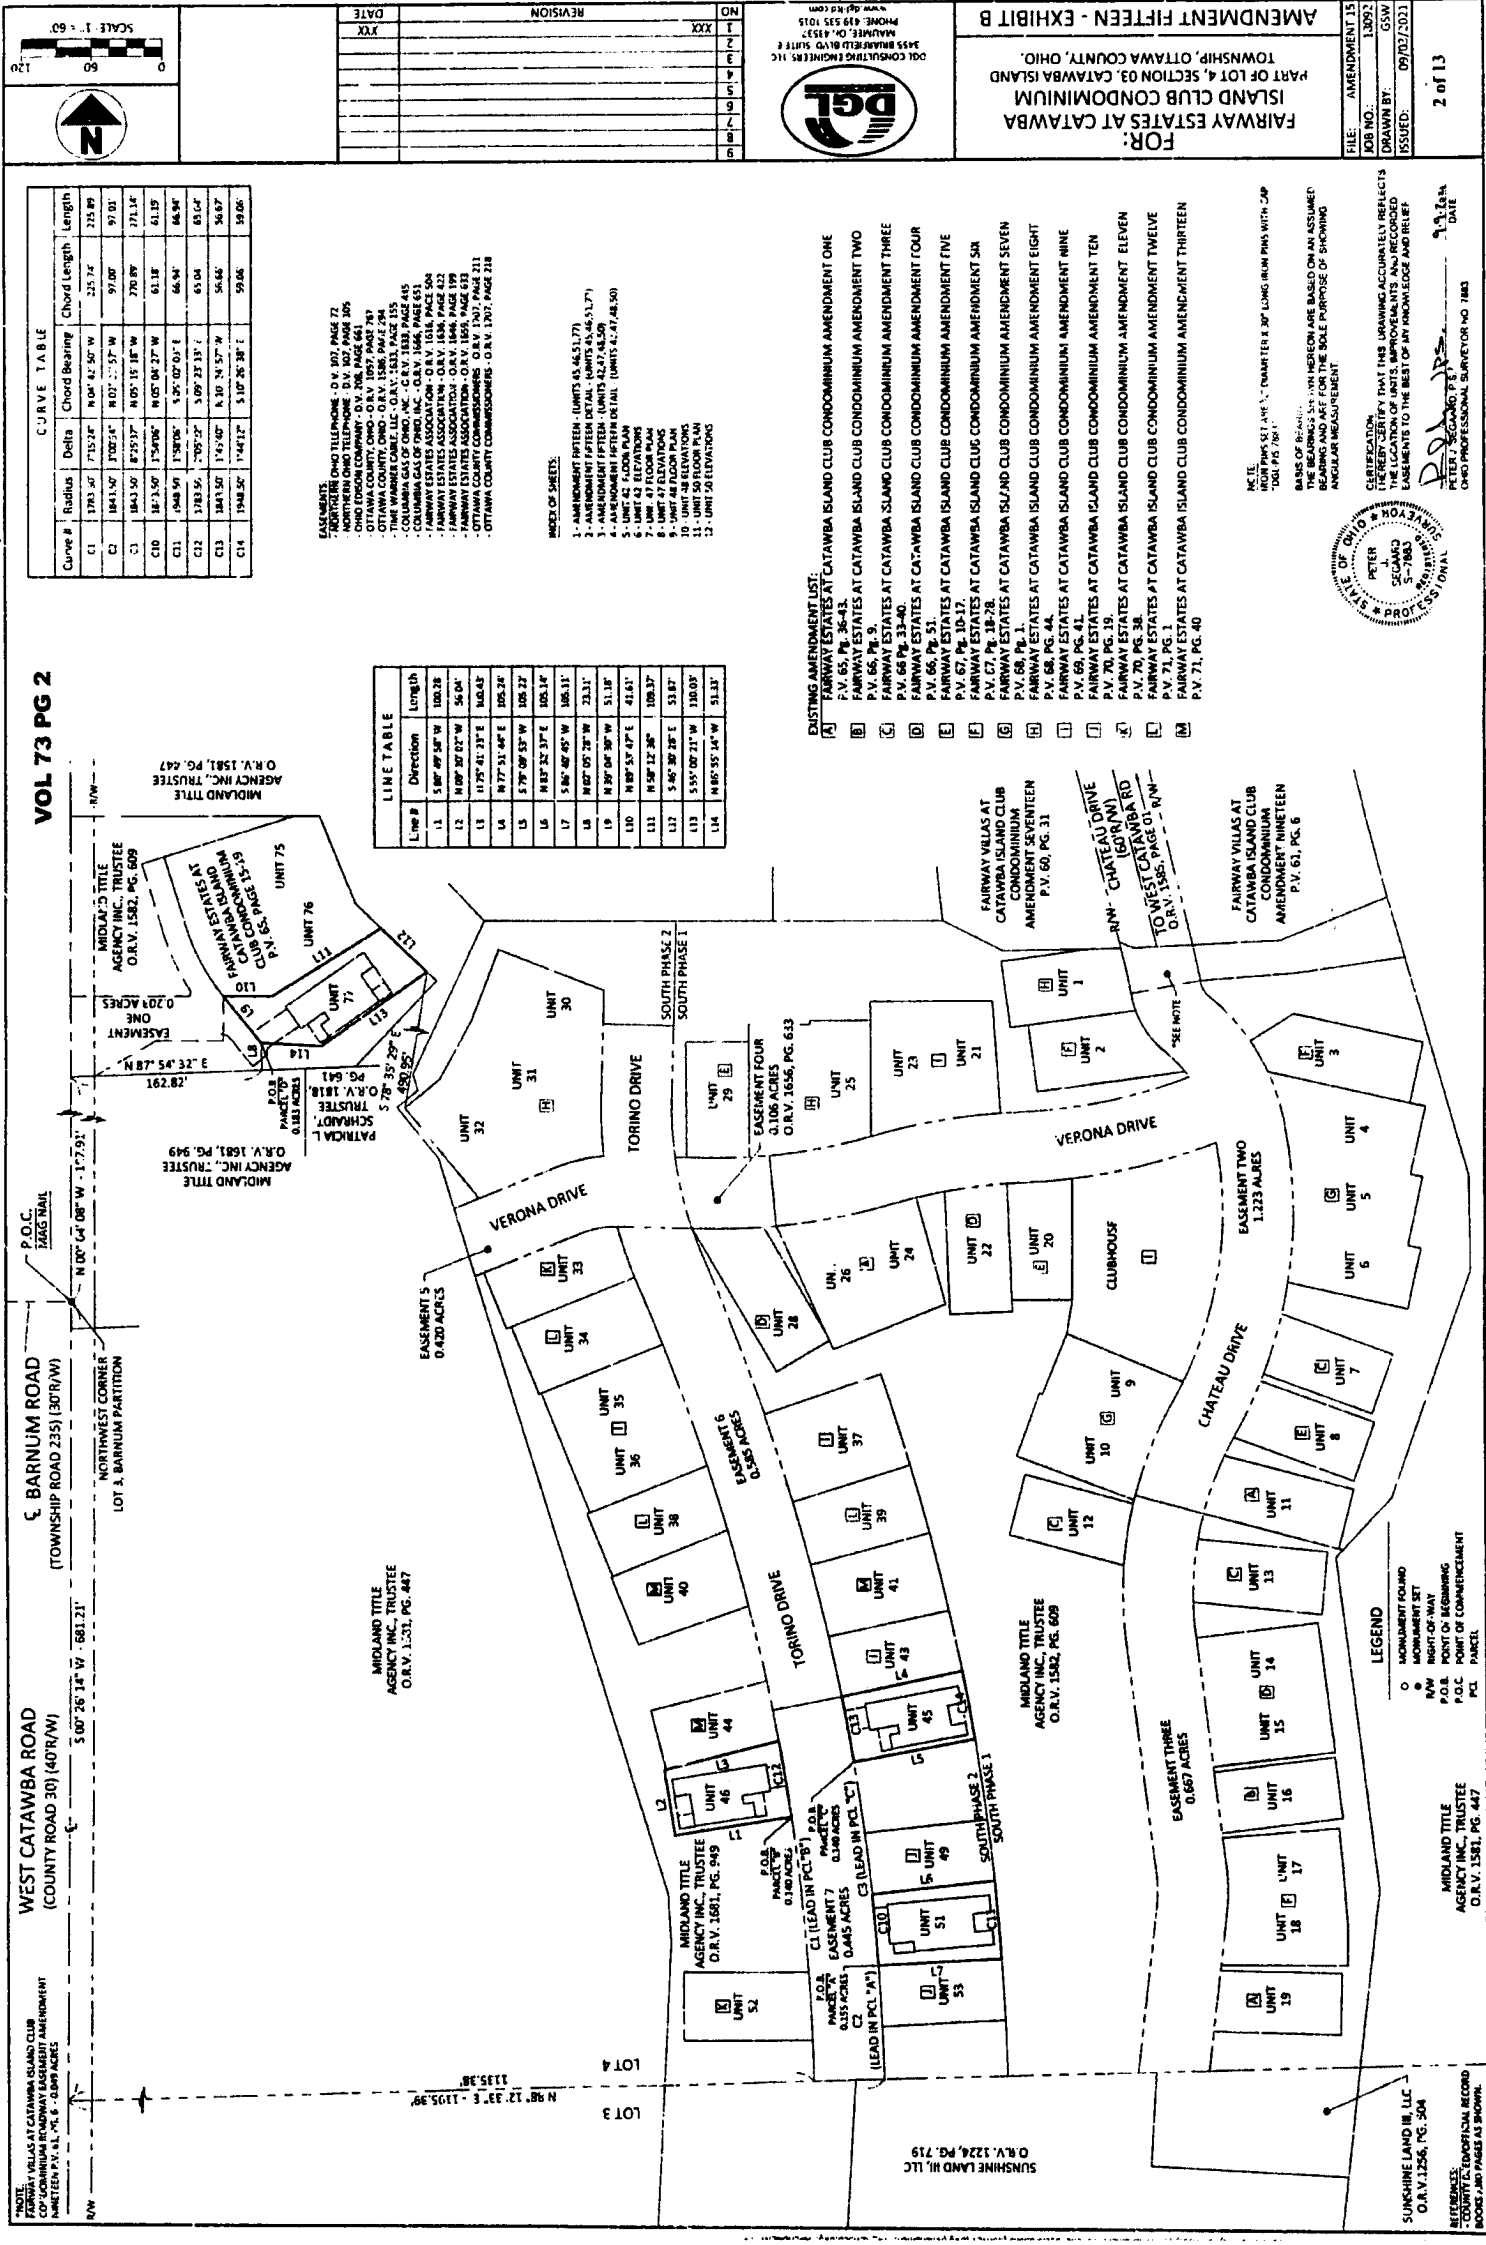

VOL 73 PG 2

CURVE TABLE

Curve #	Radius	Delta	Chord Bearing	Chord Length	Length

- EASEMENTS:**

- KEYS OF SHEETS:**
- 1 - AMENDMENT FIFTEEN - (UNITS 45, 46, 51, 52)

LIME TABLE

Line #	Direction	Length

- EXISTING AMENDMENT LIST:**

FOR:
FAIRWAY ESTATES AT CATAWBA ISLAND CLUB CONDOMINIUM
 PART OF LOT 4, SECTION 03, CATAWBA ISLAND TOWNSHIP, OTTAWA COUNTY, OHIO.

AMENDMENT 15
 JOB NO.: 15023
 DRAWN BY: GSW
 ISSUED: 09/02/2021

2 of 13

DATE: 9/13/21

PETER J. SEGONDIA
 CHD PROFESSIONAL SURVEYOR NO. 11863




NOTICE:
 FAIRWAY VILLAGES AT CATAWBA ISLAND CLUB CONDOMINIUM RECONSTRUCTION EASEMENT AMENDMENT FIFTEEN P.L. PG. 6 - 1335.38

LEGEND


- MONUMENT FOUND
- MONUMENT SET
- N/W POINT OF BEGINNING
- P.O.C. POINT OF COMMENCEMENT
- PCL PARCEL

REFERENCES:
 SUNSHINE LAND III, LLC O.R.V. 1226, PG. 504
 MIDLAND TITLE AGENCY INC., TRUSTEE O.R.V. 1581, PG. 447


DRWING: 6/18/2020 (Fairway & Sunshore - General Survey Services)\(W:\Amendment 15 and Declaration)\SURVEY\Day\Amendment 14_REVISED.dwg AMENDMENT 14 DETAIL 1

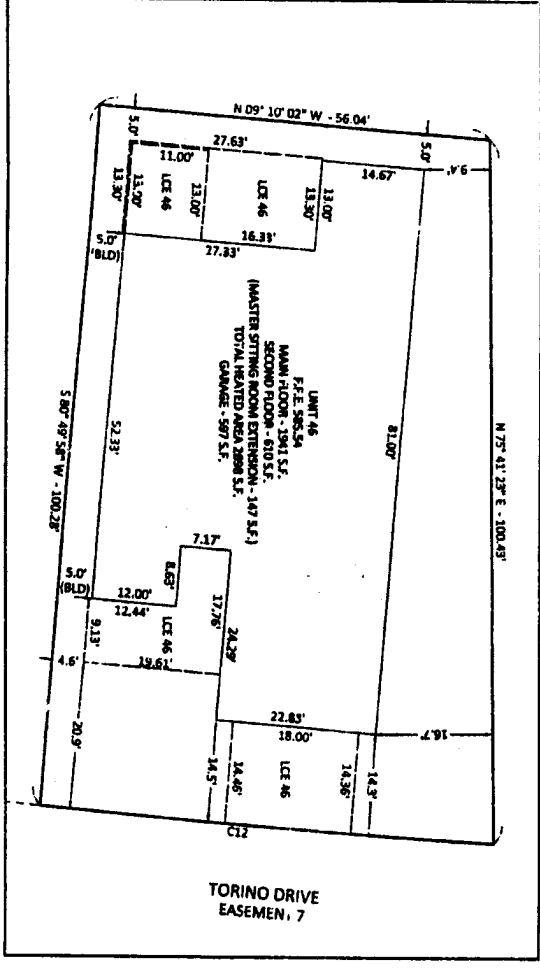


AMENDMENT FIFTEEN - PARCEL "A"
SCALE: 1"=10'

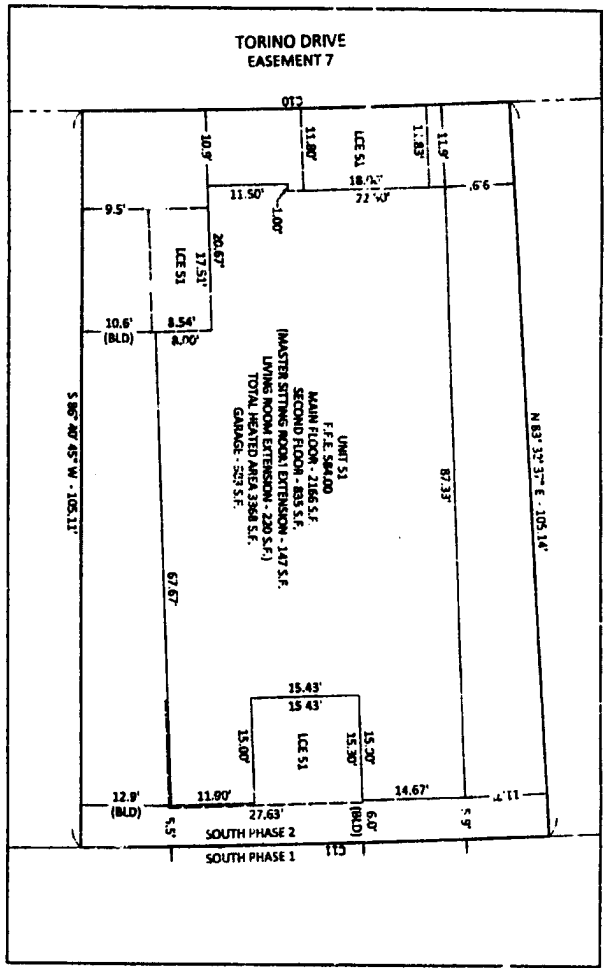

AMENDMENT FIFTEEN - PARCEL "A"
SCALE: 1"=10'

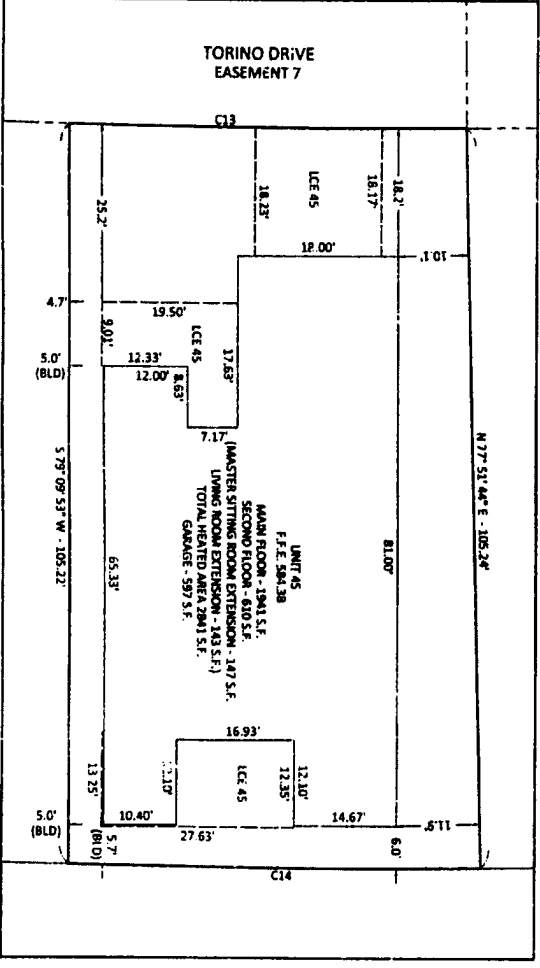

AMENDMENT FIFTEEN - PARCEL "C"
SCALE: 1"=10'

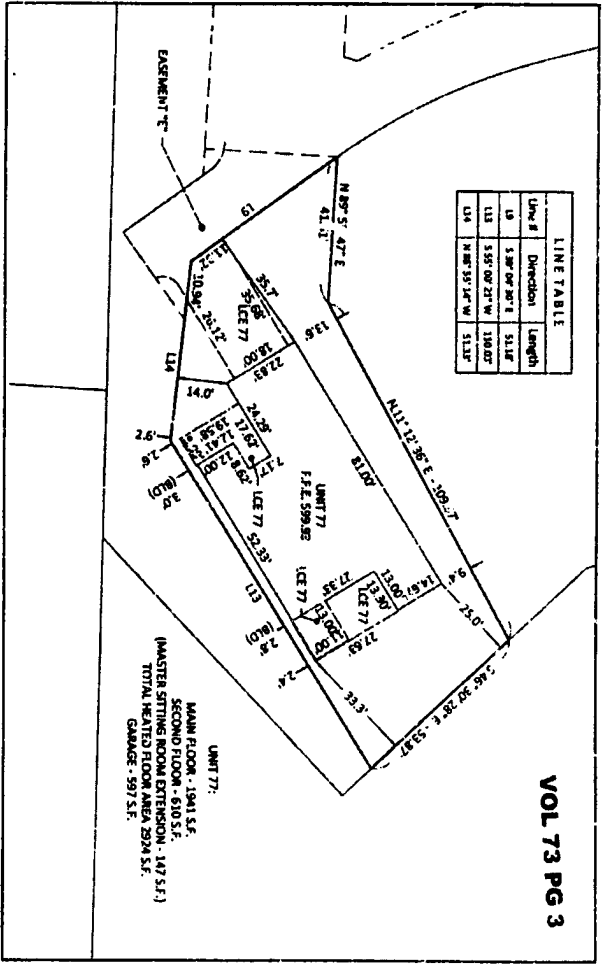

AMENDMENT FIFTEEN - PARCEL "D"
SCALE: 1"=20'


CURVE TABLE

Curve #	Radius	Delta	Chord Bearing	Chord Length	Length





VOL 73 PG 3

<p>FOR: FAIRWAY ESTATES AT CATAWBA ISLAND CLUB CONDOMINIUM PART OF LOT 4, SECTION 03, CATAWBA ISLAND TOWNSHIP, OTTAWA COUNTY, OHIO.</p> <p>AMENDMENT FIFTEEN - EXHIBIT B</p>	 DGL CONSULTING ENGINEERS, LLC 3415 BARNFIELD BLVD. SUITE 2 MAUMEE, OH 43537 PHONE: 419.331.5215 www.dglinc.com	<table border="1" style="width: 100%;"> <tr> <th>NO.</th> <th>REVISION</th> <th>DATE</th> </tr> <tr> <td>1</td> <td>XXX</td> <td></td> </tr> </table>	NO.	REVISION	DATE	1	XXX		<p>FILE: AMENDMENT15 JOB NO.: 18092 DRAWN BY: GSW ISSUED: 09/09/2021</p> <p>3 of 13</p>
NO.	REVISION	DATE							
1	XXX								


1:10 Sep 03, 2021 - 6:52am
 C:\Users\m\19206 (Fairway & Sunshyne - General Survey Services)\04 Amendment 15 and Declarations\SURVEY\Draw\Amendment 15.dwg AMENDMENT 15 DETAIL 1

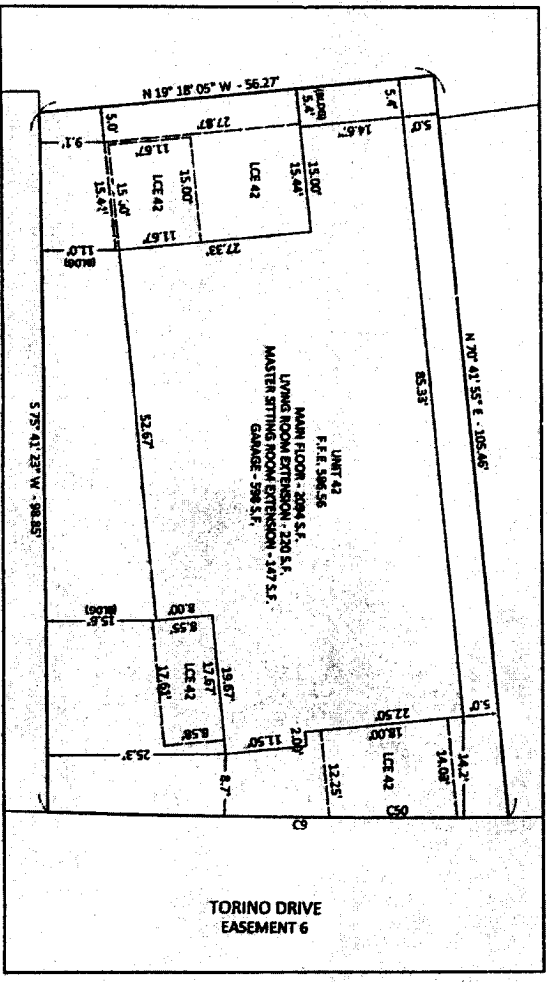

AMENDMENT FIFTEEN - PARCEL "C"
 SCALE: 1"=10'

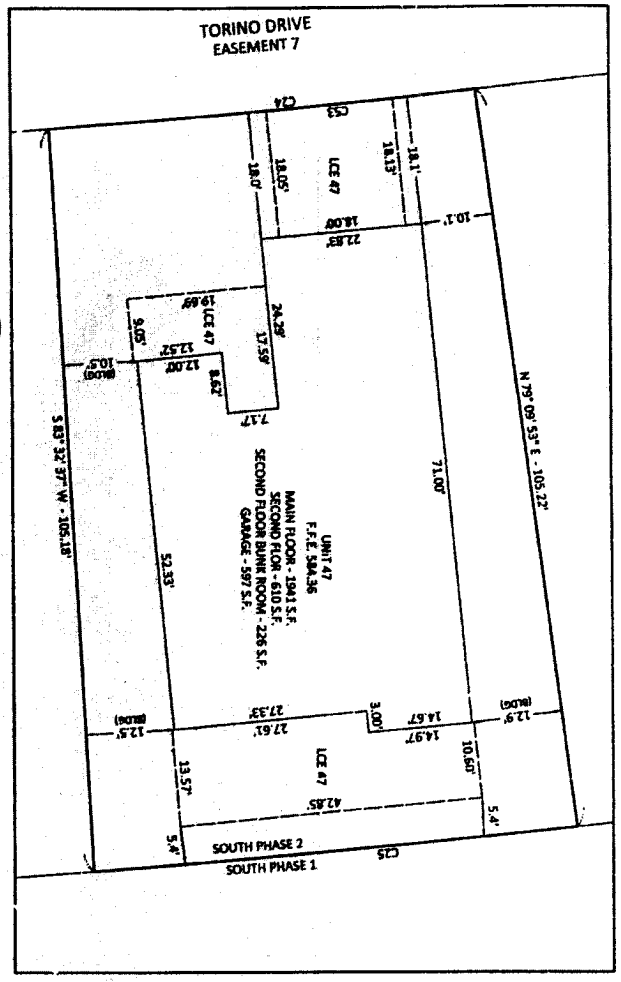

AMENDMENT FIFTEEN - PARCEL "B"
 SCALE: 1"=10'

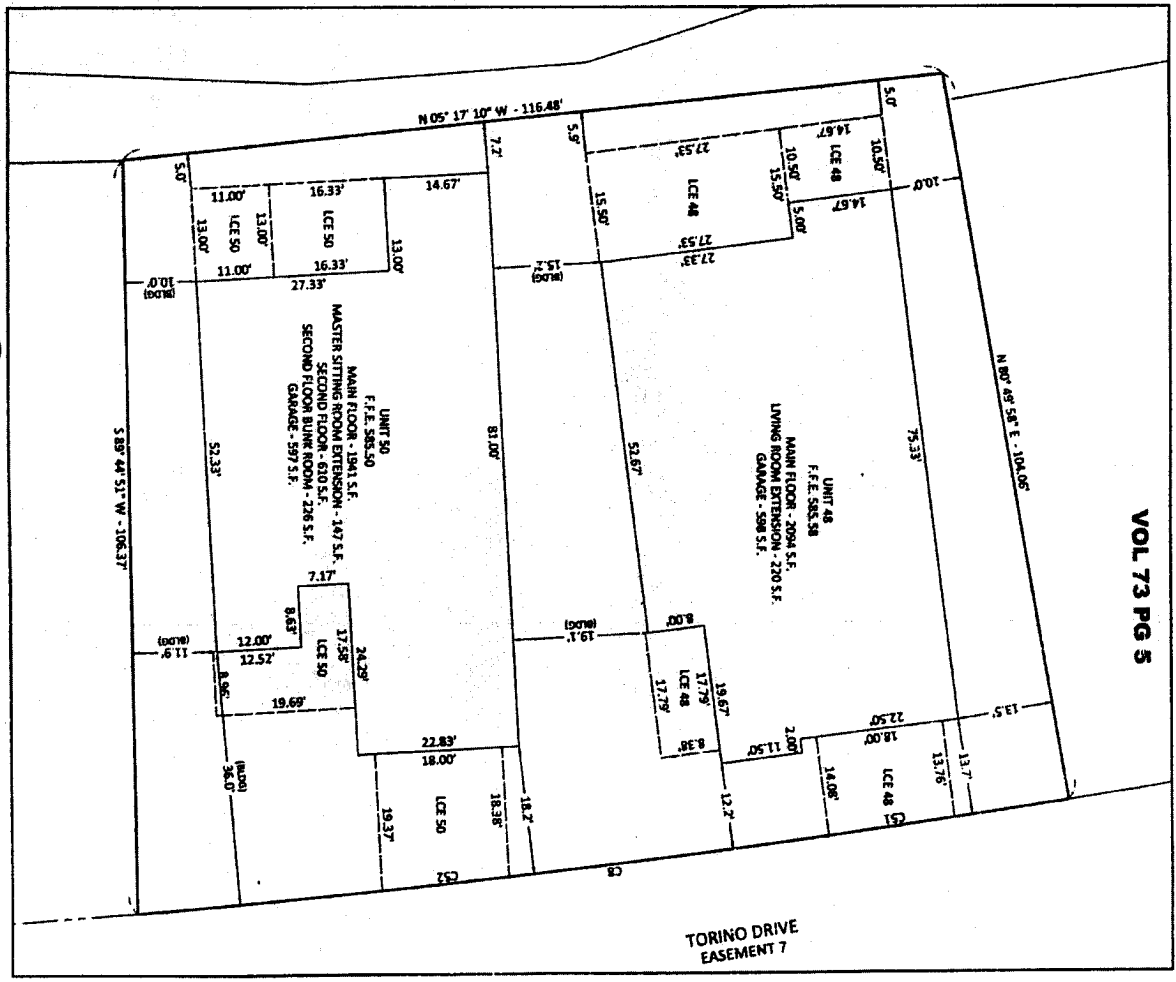

AMENDMENT FIFTEEN - PARCEL "A"
 SCALE: 1"=20'

CURVE TABLE

Curve #	Radius	Delta	Chord Bearing	Chord Length	Length



VOL 73 PG 5

FOR:
 FAIRWAY ESTATES AT CATAWBA
 ISLAND CLUB CONDOMINIUM
 PART OF LOT 4, SECTION 03, CATAWBA ISLAND
 TOWNSHIP, OTTAWA COUNTY, OHIO.



DGL CONSULTING ENGINEERS, LLC

NO	REVISION	DATE
1	XXX	
2		
3		
4		
5		
6		
7		
8		

5 of 13
 JOB NO.: AMENDMENT 15
 DATE: 130626-04
 DRAWN BY: GSW
 ISSUED: 09/02/2021

AMENDMENT FIFTEEN - EXHIBIT B