

NOTE:  
 AREAS DESIGNATED THIS MANNER INDICATE LIMITED  
 COMMON ELEMENTS PERTAINING TO ADJACENT UNIT  
 L.C.E. = LIMITED COMMON ELEMENT

BUILDING NO. 21 - 2750 CANTERBURY CIRCLE





FLOOR PLAN

SCALE:  
 1/8" = 1'-0"

I certify that this drawing, consisting of 2 sheets, accurately shows  
 each building of FAIRWAY VILLAS AT CATAWBA ISLAND CLUB, as  
 constructed with respect to the property shown on this drawing, for  
 the sole purpose of complying with ORC 5311.07



By: *[Signature]*  
 Date: 10/10/07  
 Michael J. Ventrone - Registered Architect No. 4586

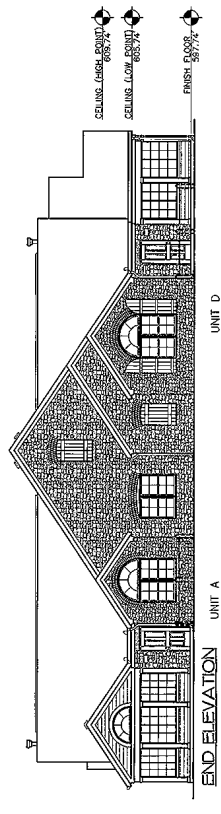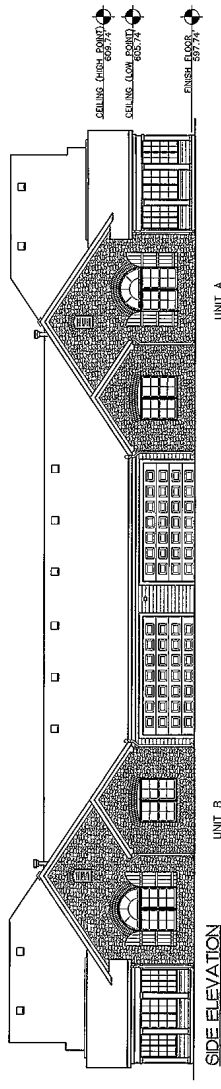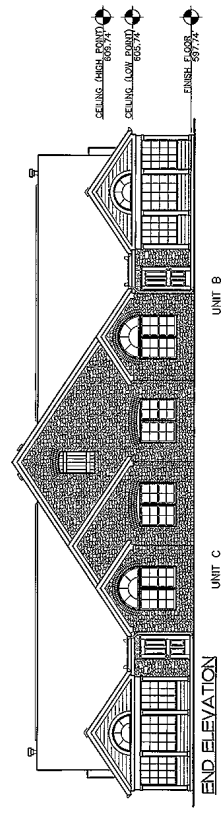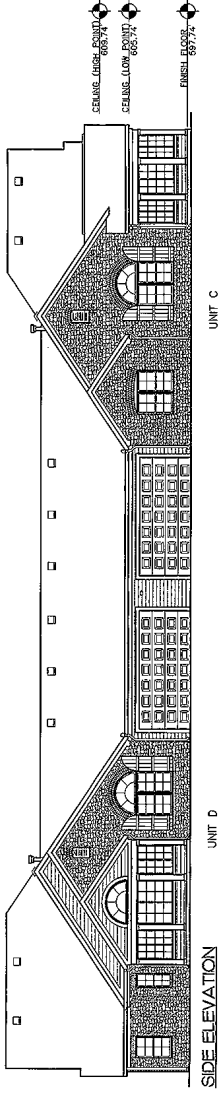

BUILDING NO. 21 - 2750 CANTERBURY CIRCLE



Scale: 1/8" = 1'-0"