BUILDING 24 LEFT

BUILDING 24 FRONT

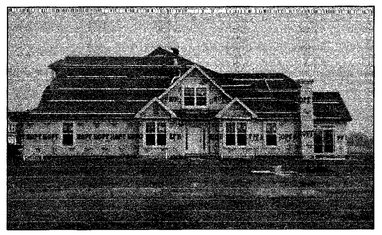

BUILDING 24 RIGHT

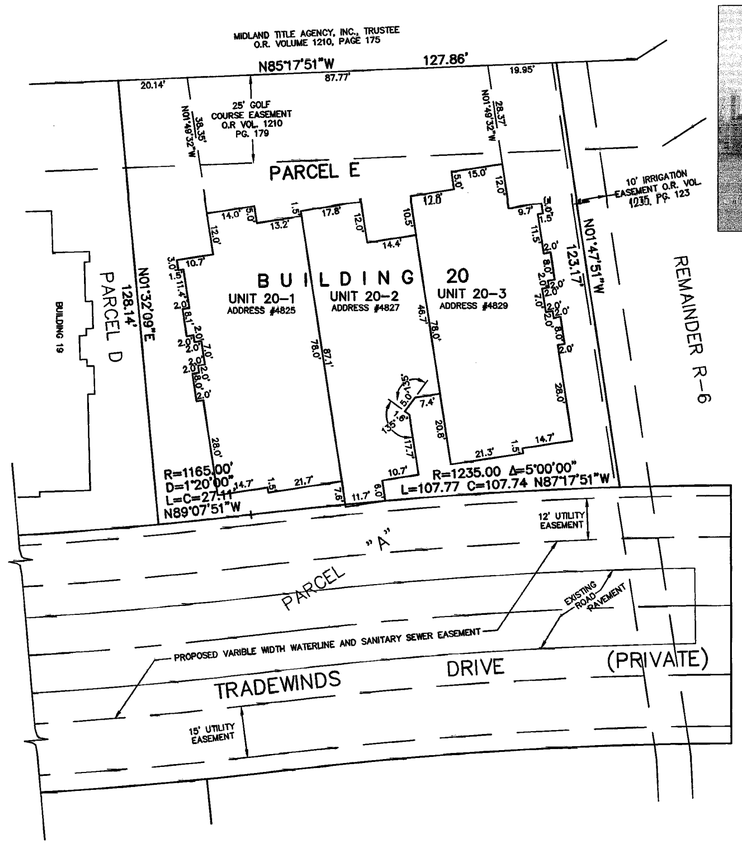

BUILDING 20 REAR

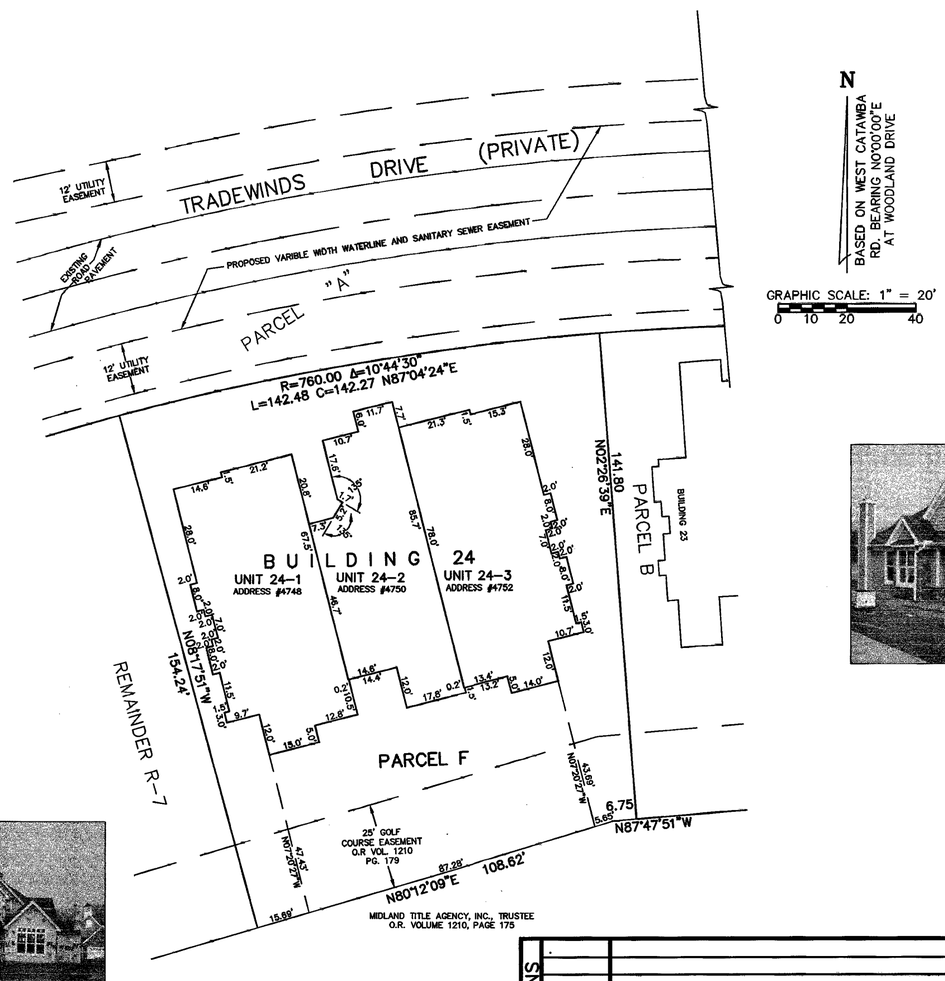

BUILDING 24 REAR

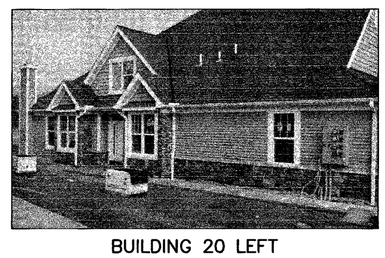

BUILDING 20 LEFT

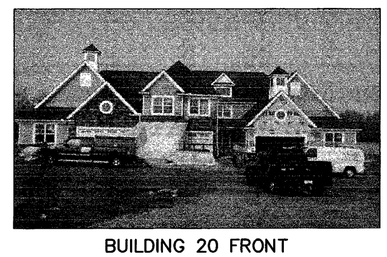

BUILDING 20 FRONT

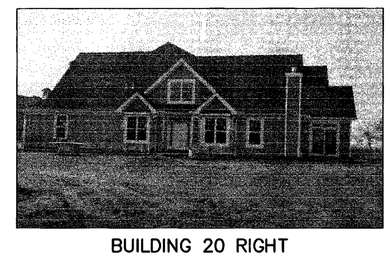

BUILDING 20 RIGHT

UNIT HEIGHTS:
(DISTANCES FROM FLOOR TO CEILING)
GARAGE AREA: 9.5'
GROUND FLOOR:
LIVING SPACES BELOW SECOND FLOOR: 9.0'
LIVING SPACES OPEN TO ABOVE: 18.0'
BEDROOM SPACES: 12.0'
BATHROOM AND STORAGE SPACES: 8.0'
SECOND FLOOR: 8.0'

REVISIONS

HARBOR'S EDGE AT CATAWBA ISLAND CLUB CONDO #4 PH. 5

OF PART OF CATAWABA ISLAND TWP., SECTION 3, ORIGINAL LOT 5, OF THE WESTERN RESERVE, OTTAWA COUNTY, OHIO

THE HENRY G. REITZ ENGINEERING COMPANY
4214 ROCKY RIVER DRIVE
CLEVELAND, OHIO 44135
PHONE: (216) 251-3033

MARCH 2012

L:\dwgs\K\catawba\condos\condo-4-5.dwg, 1:20