LAKE IN THE WOODS CONDOMINIUM
PHASE I-E
CATAWBA ISLAND TOWNSHIP, OTTAWA COUNTY, OHIO

Curve No.	Radius	Delta	Length	Tangent	Chord
1	84.70	030°37'04"	00.00	00.00	S 70°00'50"W 00.00

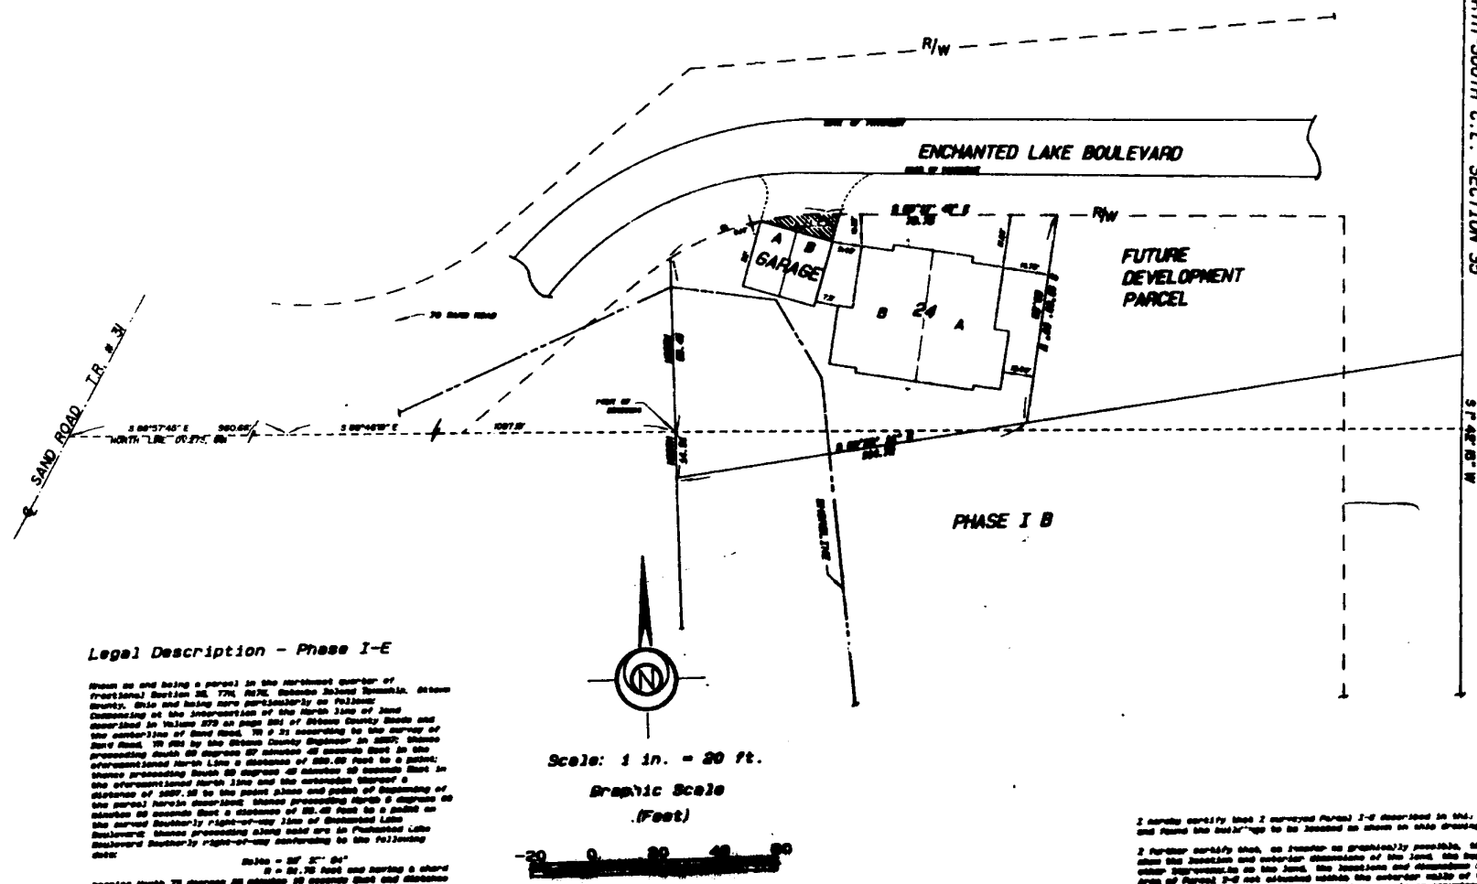

Legal Description - Phase I-E

[illegible]

The above Legal Description is based on the assumption that the North-South centerline of Fractional Section 35, T3N, R15E, Catawba Island Township, Ottawa County, Ohio bears South 1 degree 46 minutes 18 seconds West.

$ 50.00
RECEIVED: Oct. 18, 1989
TIME: 11:15 AM
[illegible]

I hereby certify that I surveyed Parcel I-E described in this Declaration and found the buildings to be located as shown on this drawing.

I further certify that, as inspected as practically possible, the detailed plans that location and exterior dimensions of the land, the buildings and other improvements on the land, the location and dimensions of the common area of Parcel I-E and situated within the exterior walls of the buildings on Parcels I-E, and the locations of all easements or appurtenances as shown on Parcel I-E. There are no encroachments except as noted on this sheet.

[illegible] P.E.&S.
David A. [illegible] P.E., P.S.
Registered Engineer & Ohio
Professional Surveyor in Ohio
Graphic Engineering Systems Inc.
[illegible]
Date: 10/4/89

10/4/89
Date

STATE OF OHIO
DAVID ALBERT