

# OTTAWA COUNTY ENGINEERS OFFICE

REFERENCE NO. 2-6-13-H  
SOUTH QUARTER POST SEC. 2  
CLAY TWP.  
SHEET 1 OF 1.

PERSONNEL:  
M. WITTMAN, P.S.  
J. ALLEN

DATE / WEATHER / TEMP:  
JULY 30, 2020  
OVERCAST, HUMID - NE  
85° F

ROUTE: T-4 CAMPER RD.

TOWNSHIP: CLAY


SECTION: 2

T 6 NR 13 E.

NORTHING:

EASTING:


DATUM:

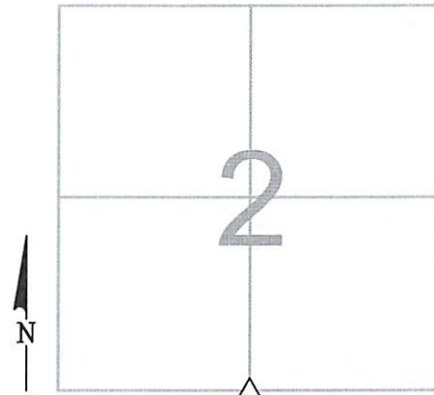

## MONUMENT INFORMATION

MONUMENT TYPE: FD. HARDHEAD STONE  
ON SURFACE - BELOW: 1.00'  
LEFT - CL PAV'T - RIGHT: 2.05'

8" x 7" TRIANGULAR STONE W/ DRILL HOLE

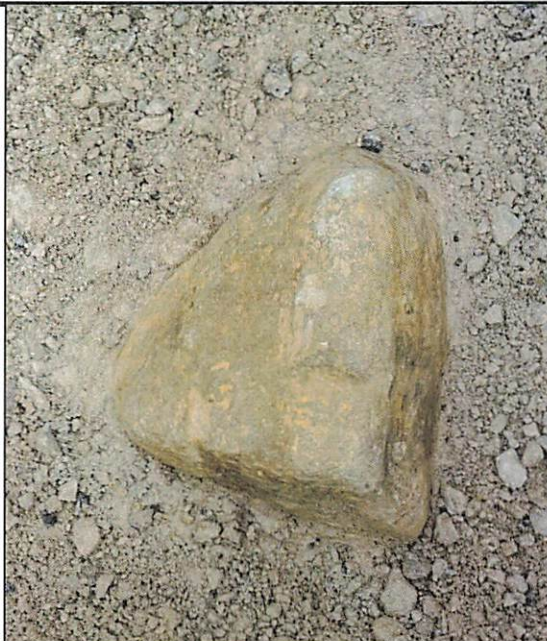

## MISC. INFORMATION

FD 1" Ø IRON PIN W/ DRILL HOLE ON SURFACE,  
TIED W/ X-TIES AND DUG FOR STONE. DRILL  
HOLE IN PIN WAS ON LINE NORTH AND SOUTH  
AND 036' WEST OF DRILL HOLE USED IN STONE.

JULY 30, 2020

SET 1" SQUARE IRON PIN  
IN MONUMENT BOX OVER  
STONE

