

OTTAWA COUNTY ENGINEERS OFFICE

REFERENCE NO. 20-7-13-A
NW CORNER POST SECTION 20
CLAY TWP.
SHEET 1 OF 1.

ROUTE: C-66 MOLINE-MARTIN RD. @
T- 54 BILLMAN RD.

TOWNSHIP: CLAY


SECTION: 20

T 7 NR 13 E.

NORTHING:

EASTING:

DATUM:

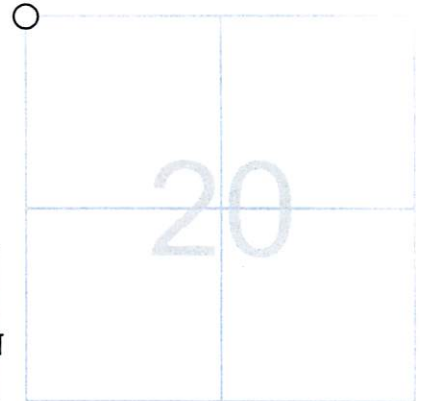

PERSONNEL:

M. WITTMAN, P.S.
J. ALLEN
E. KOCH, C. MILLER
T. RAHM, K. LENKE - GARAGE

DATE / WEATHER / TEMP:


JULY 14, 2009
SUNNY
68° F

MONUMENT INFORMATION

MONUMENT TYPE: FD 1" Ø IRON PIN
ON SURFACE - BELOW: 0.35'
LEFT - CL PAV'T - RIGHT: 7.90'

PER COUNTY RECORDS

SET DRILL HOLE IN CENTER OF PIN.

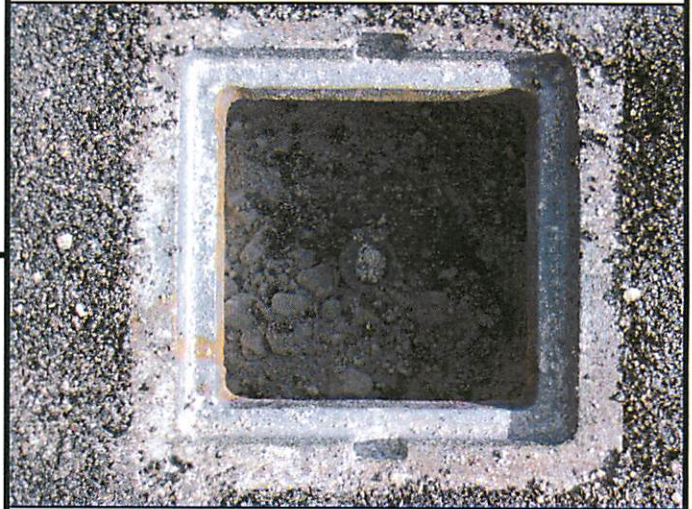

MISC. INFORMATION

FD. PK NAIL 0.02' BELOW SURFACE - PK WAS
OVER IRON PIN.

JULY 14, 2009

SET MONUMENT BOX OVER
IRON PIN

