


OTTAWA COUNTY BENCHMARK DATA SHEET

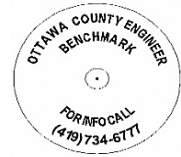

DAN 135-2.4


Township	Section	Town	Range	Type of Monument
Danbury	SEC 4 LOT 12			3 1/4" Domed Bronze Disk in Concrete (OCE Spec. BM-1)
Set By	Shot By	Calculated	Calculated By	Published
OCE / OCHD	J. Allen	March 8, 2012	M. J. Wittman, P.S.	March 16, 2012

Location

West of the intersection of Bayshore Rd., C.R. #135 & Church Rd., T.R. #137

Vertical Control		
Vertical Datum	Method	Elevation (U.S. Survey Feet)
NAVD 88	GPS	579.41

Horizontal Control			
Horizontal Datum	Zone	Northing	Easting
NAD 83 CORS 96	OHIO NORTH 3401	670,830.919	1,884,298.754
Method	Latitude	Longitude	
GPS / CORPSCON	41° 30' 27.12813" N	82° 48' 26.71350" W	
Geoid	Scale Factor	Convergence	
GEOID 09	0.999968559	- 00° 12' 07.05578"	

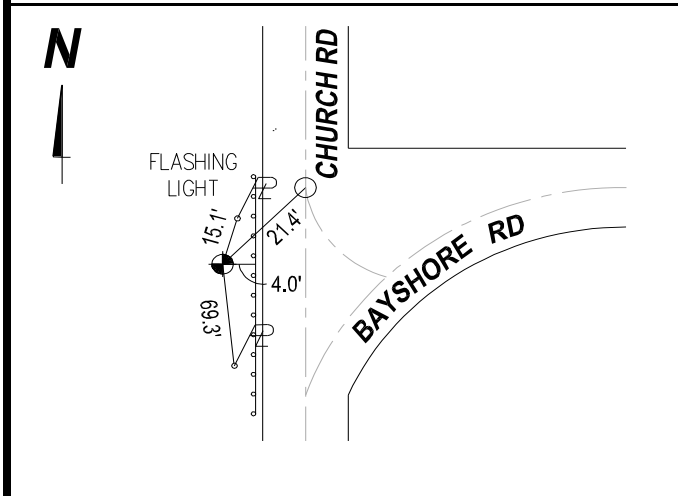

NOTES:

1. Monument set: December 22, 2011
2. Data Collected: 2-7-12, 2-16-12, 3-2-12