


# OTTAWA COUNTY BENCHMARK DATA SHEET

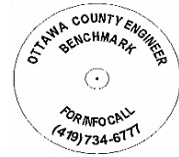

## DAN 140-0.0

Township	Section	Town	Range	Type of Monument
Danbury	SEC 1 LOT 1			3 1/4" Domed Bronze Disk in Concrete (OCE Spec. BM-1)
Set By	Shot By	Calculated	Calculated By	Published
OCE / OCHD	J. Allen	March 14, 2012	M. J. Wittman, P.S.	March 16, 2012

### Location


West side of Hartshorn Rd., T.R. #140 between Hartshorn Rd., Extension T.R. #140A and State Route #163

### Vertical Control

Vertical Datum	Method	Elevation (U.S. Survey Feet)
NAVD 88	GPS	580.11

### Horizontal Control

Horizontal Datum	Zone	Northing	Easting
NAD 83 CORS 96	OHIO NORTH 3401	673,536.950	1,896,780.271
Method	Latitude	Longitude	
GPS / CORPSCON	41° 30' 54.26620" N	84° 45' 42.76841" W	
Geoid	Scale Factor	Convergence	
GEOID 09	0.999969577	- 00° 10' 19.35200"	

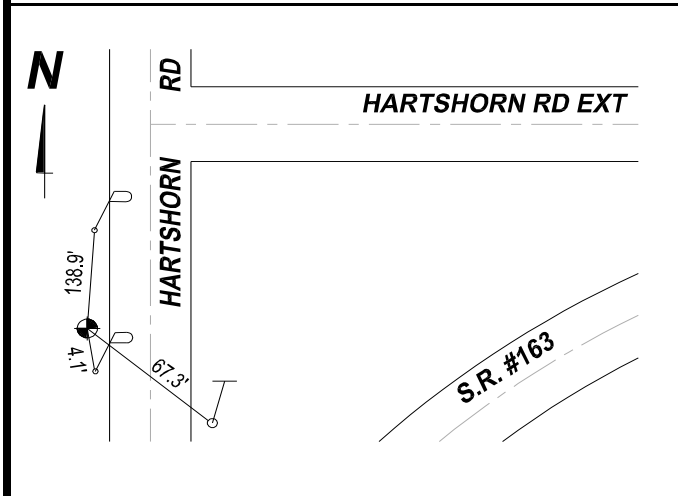

**NOTES:**

1. Monument set: December 22, 2011
2. Data Collected: 2-7-12, 3-2-12, 3-8-12