


# OTTAWA COUNTY BENCHMARK DATA SHEET

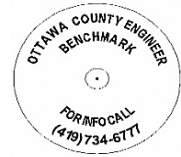

## DAN 142-0.0

<b>Township</b>	<b>Section</b>	<b>Town</b>	<b>Range</b>	<b>Type of Monument</b>
Danbury	SEC 1 LOT 30			3 1/4" Domed Bronze Disk in Concrete (OCE Spec. BM-1)
<b>Set By</b>	<b>Shot By</b>	<b>Calculated</b>	<b>Calculated By</b>	<b>Published</b>
OCE / OCHD	M. J. Wittman, P.S., J. Allen	March 14, 2012	M. J. Wittman, P.S.	March 16, 2012

### Location


West side of Alexander Pike, north of State Route #163. (In the Village of Marblehead)

### Vertical Control

<b>Vertical Datum</b>	<b>Method</b>	<b>Elevation (U.S. Survey Feet)</b>
NAVD 88	GPS / LEVEL	609.52

### Horizontal Control

<b>Horizontal Datum</b>	<b>Zone</b>	<b>Northing</b>	<b>Easting</b>
<b>Method</b>	<b>Latitude</b>	<b>Longitude</b>	
<b>Geoid</b>	<b>Scale Factor</b>	<b>Convergence</b>	

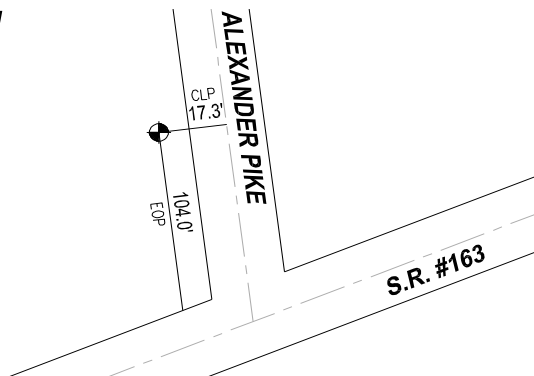

#### **NOTES:**

1. Monument set: December 22, 2011
2. Data Collected: 2-7-12, 2-16-12, 3-2-12, 3-13-12
3. Not suitable for GPS
4. Corrected elevation error 4-20-17 (MJW)