



# OTTAWA COUNTY BENCHMARK DATA SHEET



## DAN 5-2.2


Township	Section	Town	Range	Type of Monument
Danbury	SEC 4 LOT 12			3 1/4" Domed Bronze Disk in Concrete (OCE Spec. BM-1)
Set By	Shot By	Calculated	Calculated By	Published
OCE / OCHD	J. Allen	March 14, 2012	M. J. Wittman, P.S.	March 16, 2012

**Location**

North side of Port Clinton Eastern Rd., C.R. #5, west of Curch Rd., T.R. #137  
(Southwest of old barn)

Vertical Control		
Vertical Datum	Method	Elevation (U.S. Survey Feet)
NAVD 88	GPS	587.21

Horizontal Control			
Horizontal Datum	Zone	Northing	Easting
NAD 83 CORS 96	OHIO NORTH 3401	674,747.218	1,884,019.193
Method	Latitude	Longitude	
GPS / CORPSCON	41° 31' 05.81135" N	82° 48' 30.57000" W	
Geoid	Scale Factor	Convergence	
GEOID 09	0.999970015	- 00° 12' 09.58931"	

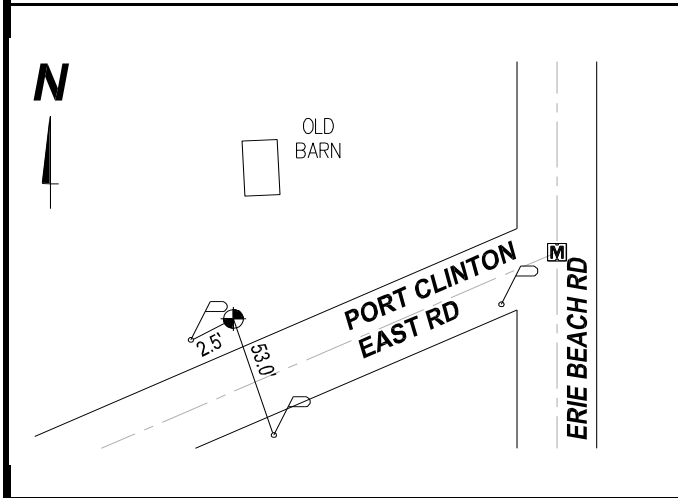

**NOTES:**

1. Monument set: December 22, 2011
2. Data Collected: 2-7-12, 2-16-12, 3-12-12